IREDELL COUNTY HEALTH DEPARTMENT

Statesville Phone TR 3-7271 Mooresville Phone NO 3-1271

PERMIT TO INSTALL SEPTIC TANK

Permit NO. 721 Permit Date NOV 22 1967

Owner Dearborn Bldg Co. Address R 7

Installed By C Hoke Address R 7


Location of Property Washington Forest S/D on Wallace Springs Rd. on R. before 3rd creek Bridge

Tank		Capacity		Length of Lines		Fixtures	
Block	( )	1000	(✓)	225'	( )	No. of Baths	(2)
Precast	(✓)	1250	( )	250'	( )	Dishwasher	( )
		1500	( )	Other		Garbage Grdr.	( )
		Other				Other	

NOTIFY HEALTH DEPARTMENT AT LEAST EIGHT HOURS BEFORE TANK IS TO BE INSPECTED.

Final Inspection 19 Approved ( ) Disapproved ( )

Remarks Central Water Supply - Very narrow lot tank 4 ft off house & 2 ft off prop. line

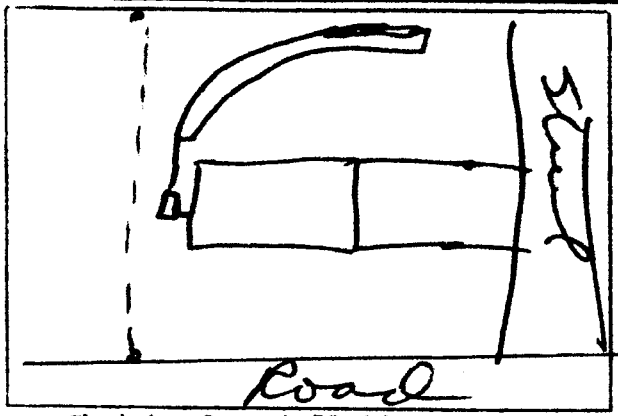

Sketch of Installation

Sanitarian