IREDELL COUNTY HEALTH DEPARTMENT

Statesville Phone TR 3-7271 Mooresville Phone NO 3-1271

PERMIT TO INSTALL SEPTIC TANK

Permit No. _____ Permit Date Feb 23 1965

Owner Hoyle Bros. Address Statesville

Installed By Roy Trott Address Statesville


Location of Property Wallis Springs Rd. 2nd Lane Left Rd. before creek first House on Right

Tank		Capacity		Length of Lines		Fixtures	
Block	( )	1000	(✓)	225'	(✓)	No. of Baths	(1)
Precast	( )	1250	( )	250'	( )	Dishwasher	( )
Poured		1500	( )	Other _____		Garbage Grdr.	( )
		Other _____				Other _____	

NOTIFY HEALTH DEPARTMENT AT LEAST EIGHT HOURS BEFORE TANK IS TO BE INSPECTED.

Final Inspection 2-23 1965 Approved (✓) Disapproved ( )

Remarks _____

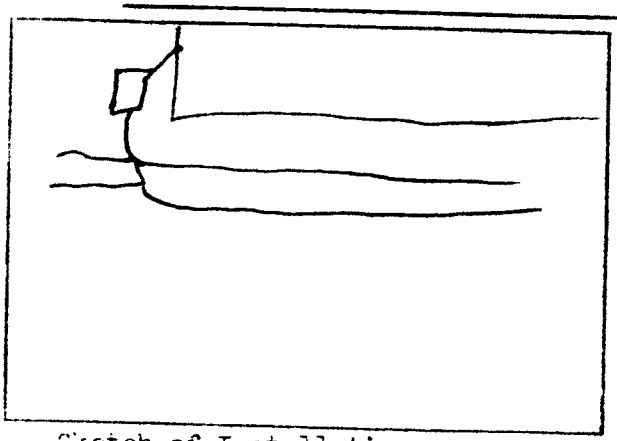

Sketch of Installation

Rat

Sanitarian