IREDELL COUNTY HEALTH DEPARTMENT

Statesville Phone TR 3-7271 Mooresville Phone NO 3-1271

PERMIT TO INSTALL SEPTIC TANK

Permit NO. _____ Permit Date 6-18-1962

Owner Clyde Albert Elder Address Glen Echo.

Installed By CLYDE HOKE Address _____


Location of Property on Corner 2nd Street to R.

Tank	Capacity	Length of Lines	Fixtures
Block ( )	800 ( )	150' ( )	No. of Baths (2)
Precast (1)	900 ( )	175' ( )	Dishwasher ( )
	1000 (1)	200' ( )	Garbage Grdr. ( )
Cash	1100 ( )	225' (1)	Auto-Washer (1)
	1200 ( )	250' ( )	Other _____
	Other _____	Other _____	

NOTIFY HEALTH DEPARTMENT AT LEAST EIGHT HOURS BEFORE TANK IS TO BE INSPECTED.

Final Inspection 6-18 1962 Approved (1) Disapproved ( )

Remarks City Water - Narrow Place to put

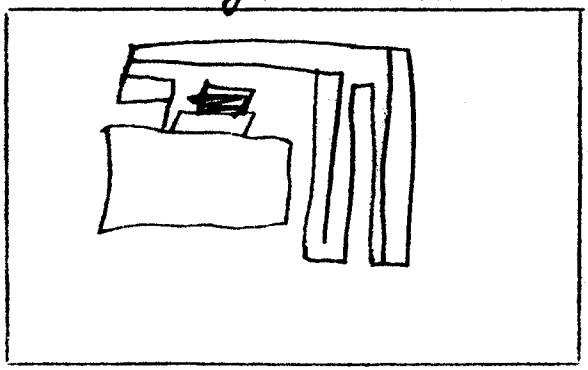

Sketch of Installation

R.A.

Sanitarian