ICHD - ENVIRONMENTAL HEALTH DIVISION

Statesville Office (704) 878-5305 Mooresville Office (704) 660-3625

PERMIT # OSWP-2022-12518

SEPTIC: IMPROVEMENT PERMIT / AUTHORIZATION TO CONSTRUCT / OPERATION PERMIT / EXISTING SYSTEM

PIN # 4733-76-6912

APPLICANT / OWNER: All Pro Enviro | APPLICANT ADDRESS: 518 lakeview drive, Mcadenville, NC 28101

SITE ADDRESS: 1906 LYNNWOOD DR, STATESVILLE, NC 28677 | PHONE: (704) 502-1263 | ALT. PHONE:


SITE DIRECTIONS: N NC 115/21 -> L Wilson Lee -> L Fayetteville -> L Lynnwood -> lot on L | SAP CONTROLLED: YES ☐ NO ☑

SUBDIVISION: | SECTION: | LOT #: | LOT AREA: 2.23 | DESIGN FLOW: 240 | L.T.A.R.: 0.3


Septic Tank: 1000 (gal)	STB: Infiltrator	Date:	☐ New System ☒ Repair ☐ Expansion	System Type: III	☒ Residence	No. Bedrooms: 2	Water Supply: City Water
Pump Tank: (gal)	PT:	Date:	System Description: Existing		☐ Business	No. Persons: 4	
Pump Make:	Model:	Serial #:	Repair System Description: 25% Reduction		☐ Other	No. Employees:	
# Nitrification Fields: 1	# Lines: 3	Linear Ft.: 202'	Maintenance Agreement Required: ☐ YES ☑ NO		☐ Slab	☑ Crawl Space	
Trench Width: 36	Trench Bottom Depth (Low side): 32		Gravel Depth: 0	☑ GRAVITY ☐ PRESSURE	☐ Basement w/ Plumbing	☐ Basement w/o Plumbing	

Comments / Conditions: Pump, crush & fill old tank. Washing machine must be connected to septic system. Install on contour, use serial distribution. Do not pave, grade, drive, park, or bury utilities in drainfield. Divert any drainage from drainfield. May alter tank location if setbacks are met.

INITIAL SITE SKETCH

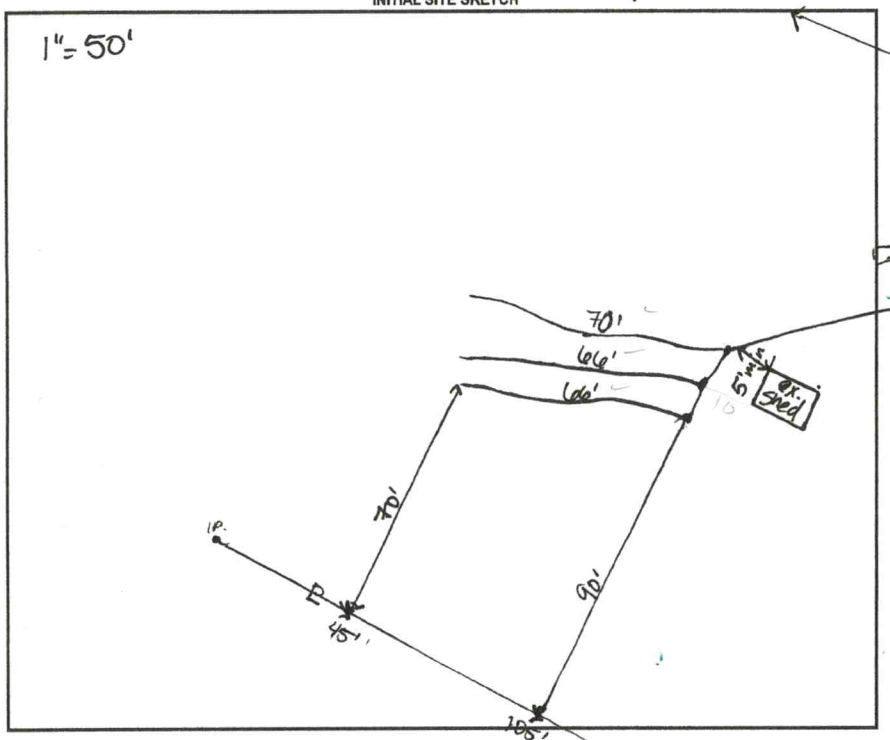

AS BUILT SKETCH

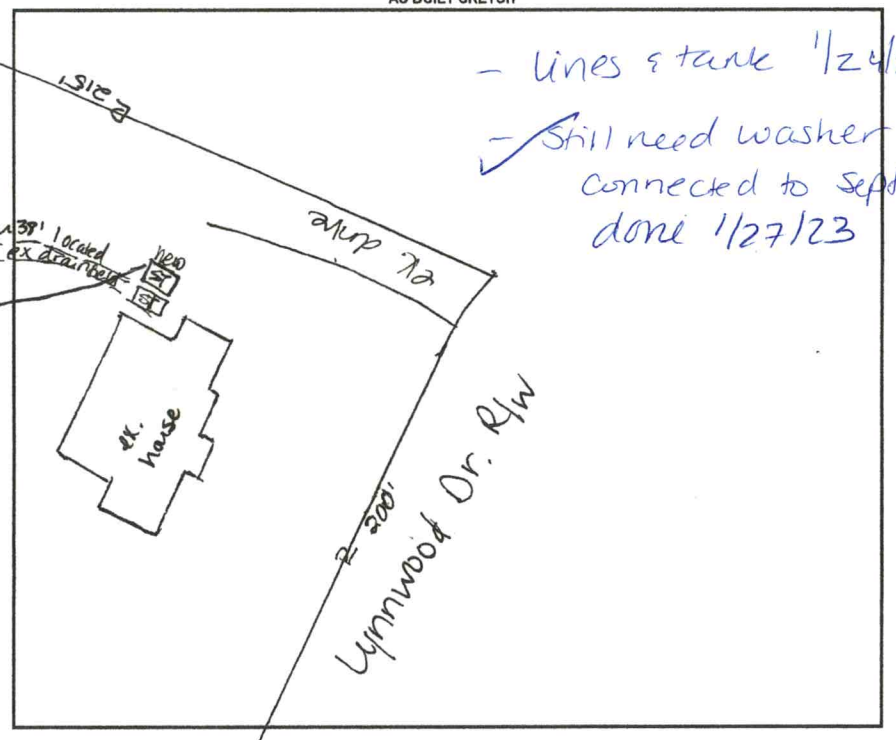

- Lines & tank 1/24/23
- Still need washer connected to septic done 1/27/23

Permit can be suspended or revoked if any false information is supplied toward securing the permit / any unauthorized changes are made to the site / any unauthorized changes are made in the installation of the system. CONTACT A LOCATOR SERVICE PRIOR TO ANY EXCAVATION

☐ IMPROVEMENT PERMIT with plat valid without expiration. ☑ IMPROVEMENT PERMIT with site plan valid for 60 mos. ☑ AUTHORIZATION TO CONSTRUCT valid for period equal to IMPROVEMENT PERMIT--not to exceed 60 mo.

Owner / Applicant Signature: Chasta Faust | Date: 01/13/2023 | Installed By: All-Pro Environmental - Cam Faust

IMPROVEMENT PERMIT by: Danielle Wieberg | Date: 01/20/23 | OPERATION PERMIT by: D Wieberg | Date: 1/27/23

AUTHORIZATION TO CONSTRUCT by: Danielle Wieberg | Date: 1/20/23 | Existing System Inspected By: | Date:

FOR SEPTIC FINAL INSPECTION CALL: 704-664-3703 BETWEEN 8am-9am the day the inspection is needed.

For LHD use only: TCT/OTH (cinders); LHD; NO type - unoccupied but damaged tank; D, A; I, G, 77yrs; 240 SP (laundry)

ICHD - ENVIRONMENTAL HEALTH DIVISION

Statesville Office (704) 878-5305 Mooresville Office (704) 660-3625

PERMIT # OSWP-2022-12518

SEPTIC: IMPROVEMENT PERMIT / AUTHORIZATION TO CONSTRUCT / OPERATION PERMIT / EXISTING SYSTEM

PIN # 4733-76-6912

APPLICANT / OWNER: All Pro Enviro | APPLICANT ADDRESS: 518 lakeview drive, Mcadenville, NC 28101

SITE ADDRESS: 1906 LYNNWOOD DR, STATESVILLE, NC 28677 | PHONE: (704) 502-1263 | ALT. PHONE:


SITE DIRECTIONS: N NC 115/21 -> L Wilson Lee -> L Fayetteville -> L Lynnwood -> lot on L | SAP CONTROLLED: YES ☐ NO ☑

SUBDIVISION: | SECTION: | LOT #: | LOT AREA: 2.23 | DESIGN FLOW: 240 | L.T.A.R.: 0.3


Septic Tank: 1000 (gal)	STB:	Date:	☐ New System ☒ Repair ☐ Expansion	System Type: III	☒ Residence	No. Bedrooms: 2	Water Supply: City Water
Pump Tank: (gal)	PT:	Date:	System Description: Existing		☐ Business	No. Persons: 4	
Pump Make:	Model:	Serial #:	Repair System Description: 25% Reduction		☐ Other	No. Employees:	
# Nitrification Fields: 1	# Lines: 3	Linear Ft.: 202'	Maintenance Agreement Required: ☐ YES ☑ NO		☐ Slab	☑ Crawl Space	
Trench Width: 36	Trench Bottom Depth (Low side): 32		Gravel Depth: 0	☑ GRAVITY ☐ PRESSURE	☐ Basement w/ Plumbing	☐ Basement w/o Plumbing	

Comments / Conditions: Pump, crush & fill old tank. Washing machine must be connected to septic system. Install on contour, use serial distribution. Do not pave, grade, drive, park, or bury utilities in drainfield. Divert any drainage from drainfield. May alter tank location if setbacks are met.

INITIAL SITE SKETCH

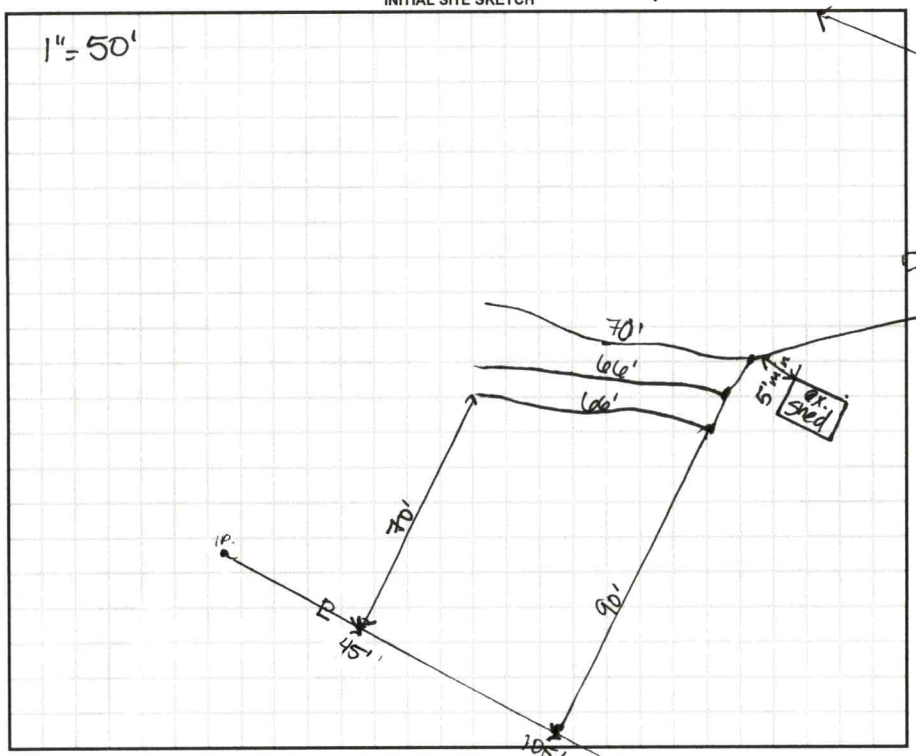

AS BUILT SKETCH

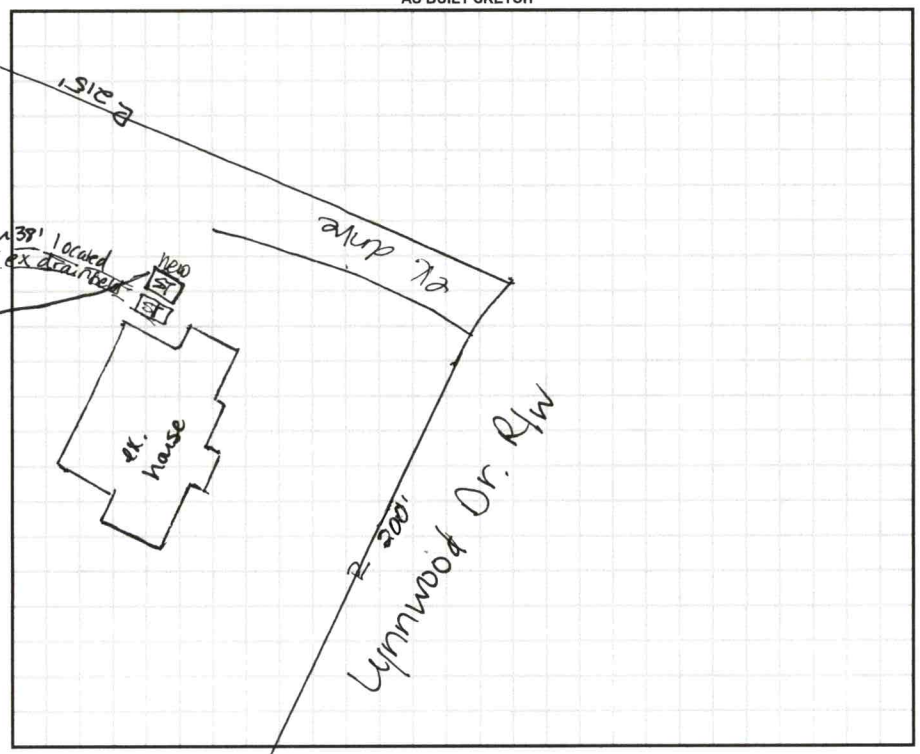

Permit can be suspended or revoked if any false information is supplied toward securing the permit / any unauthorized changes are made to the site / any unauthorized changes are made in the installation of the system. CONTACT A LOCATOR SERVICE PRIOR TO ANY EXCAVATION

☐ IMPROVEMENT PERMIT with plat valid without expiration. ☑ IMPROVEMENT PERMIT with site plan valid for 60 mos. ☑ AUTHORIZATION TO CONSTRUCT valid for period equal to IMPROVEMENT PERMIT--not to exceed 60 mo.

Owner / Applicant Signature: Chuck Faust | Date: 01/13/2023 | Installed By:

IMPROVEMENT PERMIT by: Danielle Wieberg | Date: 01/20/23 | OPERATION PERMIT by: | Date:

AUTHORIZATION TO CONSTRUCT by: Danielle Wieberg | Date: 01/20/23 | Existing System Inspected By: | Date:


FOR SEPTIC FINAL INSPECTION CALL: 704-664-3703 BETWEEN 8am-9am the day the inspection is needed.

IREDELL COUNTY HEALTH DEPARTMENT

ENVIRONMENTAL HEALTH DIVISION

PAGE 2: *SITE PLAN WORKSHEET*

SEE THE "SAMPLE SITE PLAN" BELOW. ***INCOMPLETE SITE PLANS WILL BE RETURNED TO YOU FOR COMPLETION AND MAY RESULT IN A DELAY IN THE ISSUANCE OF YOUR SEPTIC SYSTEM PERMIT!!!***

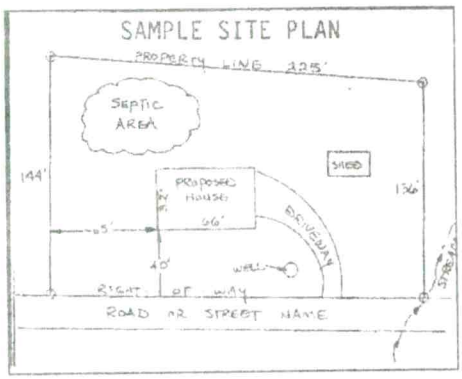

Place an (X) beside each item as you complete the site plan:


- ( ) **Property Line measurements are clearly identified**
- ( ) **All proposed structures are indicated**
- ( ) **Front and side setbacks from property line**
- ( ) **Preferred driveway location and well location**
- ( ) **Area you prefer your septic system to be placed**
- ( ) **North arrow, or other sufficient indicator of direction**

Circle N/A on the following if appropriate:

Location of septic systems and wells within 100' of your property	**N/A**
Location of easements and rights of ways on your property	**N/A**
Location of any designated wetlands on the property	**N/A**


USE THIS SPACE TO DRAW YOUR SITE PLAN

Show: proposed house or business footprint, wells, water lines, patios, pools and decks, and any other item that will occupy space on the site

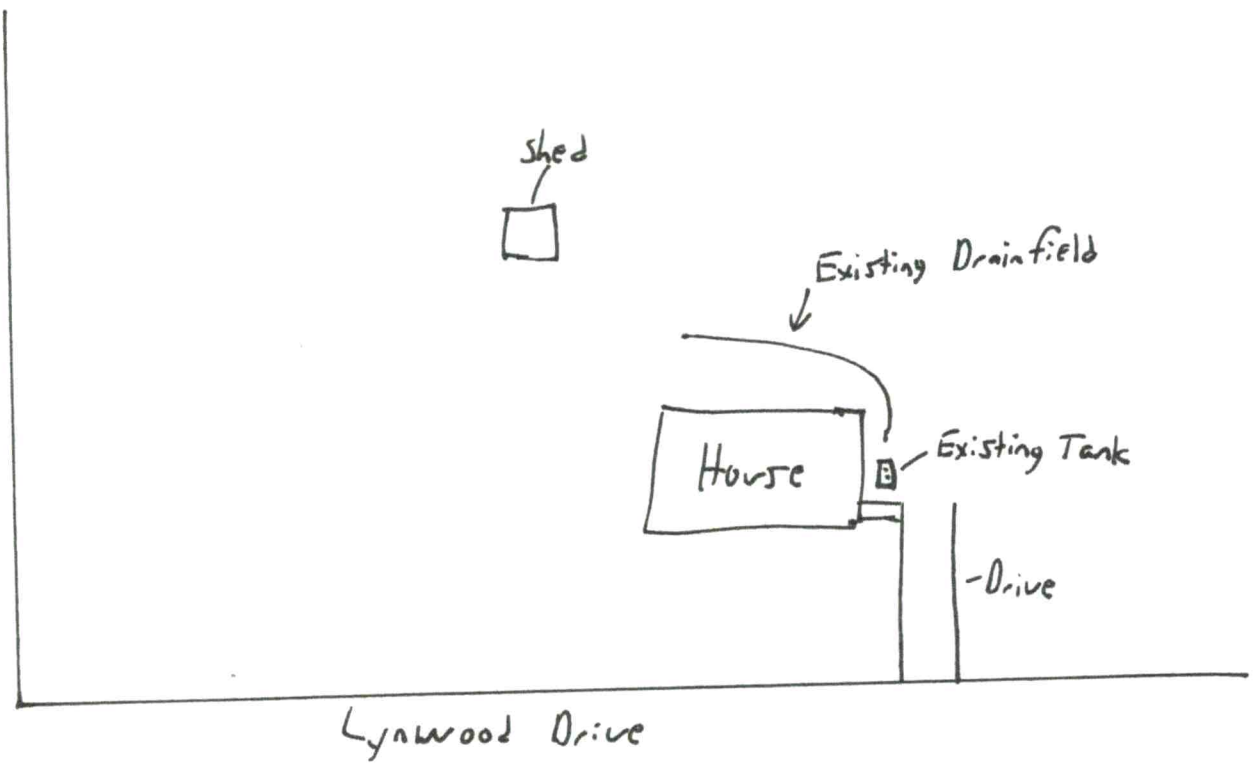

Signature: _____ _____

Property owner or owner's legal representative signature (SIGNATURE REQUIRED) DATE

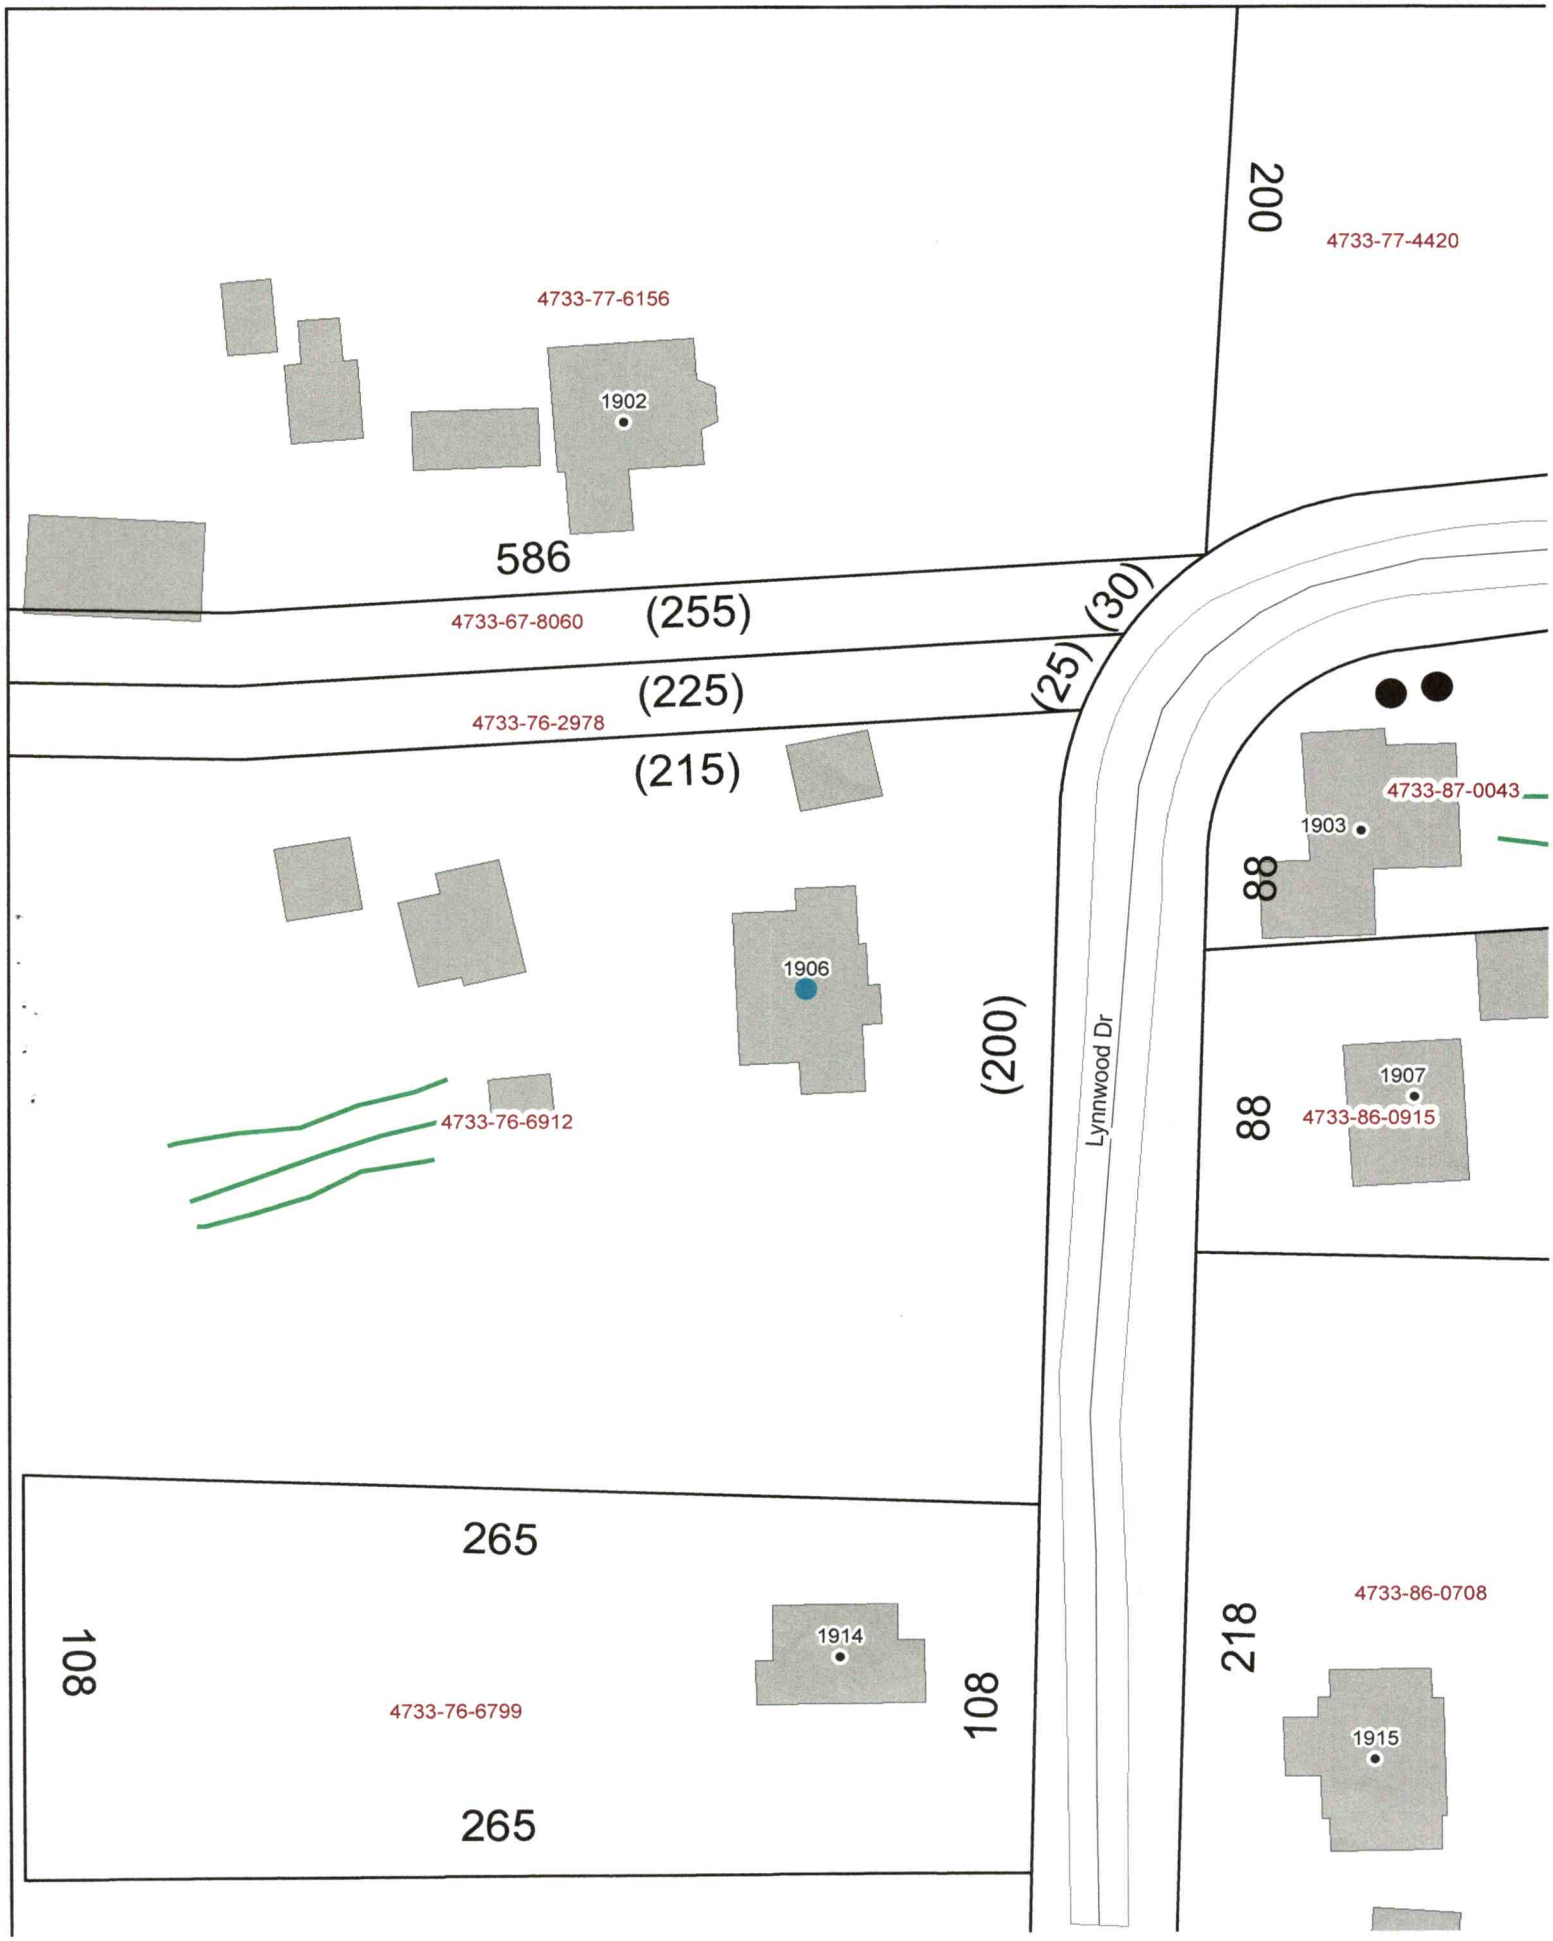
200
4733-77-4420
4733-77-6156
1902
586
4733-67-8060
(255)
(30)
(25)
(225)
4733-76-2978
(215)
4733-87-0043
1903
88
1906
(200)
Lynnwood Dr
1907
4733-86-0915
88
4733-76-6912
265
108
1914
4733-76-6799
108
4733-86-0708
218
1915
265

DEPARTMENT OF HEALTH AND HUMAN SERVICES
DIVISION OF PUBLIC HEALTH, ENVIRONMENTAL HEALTH SECTION
ON-SITE WATER PROTECTION BRANCH

Sheet 1 of 1
PROPERTY ID #: 4733966912
COUNTY: Iredell

SOIL/SITE EVALUATION
***for* ON-SITE WASTEWATER SYSTEM**
(Complete all fields in full)

OWNER: Amy Augustine
ADDRESS:
APPLICATION DATE: 12/29
DATE EVALUATED: 1/5/22
PROPOSED FACILITY: 2BR
PROPOSED DESIGN FLOW (.1949): 240
PROPERTY SIZE: 2.23
LOCATION OF SITE: 1906 Lynnwood, Statesville
PROPERTY RECORDED: Y
WATER SUPPLY: ☐ Private ☑ Public ☐ Well ☐ Spring ☐ Other
EVALUATION METHOD: ☐ Auger Boring ☐ Pit ☐ Cut
TYPE OF WASTEWATER: ☒ Sewage ☐ Industrial Process ☐ Mixed

PROFILE #	.1940 LANDSCAPE POSITION/ SLOPE %	HORIZON DEPTH (IN.)	SOIL MORPHOLOGY (.1941) .1941 STRUCTURE/ TEXTURE	.1941 CONSISTENCE/ MINERALOGY	OTHER PROFILE FACTORS .1942 SOIL WETNESS/ COLOR	.1943 SOIL DEPTH	.1956 SAPRO CLASS	.1944 RESTR HORIZ	PROFILE CLASS & LTAR
1	HS 9%	0-6	SCL SBK	SSSP-FR SCVP	sap incl 22"+ mica incl	48"	N/A	N/A	PS 0.3
		6-22	C - SBK	↓					
		22-39	CL - WSBK	↓					
		39-48	L - WSBK	SSNP-FR SCVP					
2	HS 8%	0-5	SCL SBK	SS SP SE FR	sap incl 20"+ mica incl	48"	N/A	N/A	PS 0.3
		5-20	C SBK	↓					
		20-40	CL WSBK	↓					
		40-48	L WSBK	SSNP SE FR					
3									
4									

DESCRIPTION	INITIAL SYSTEM	REPAIR SYSTEM
Available Space (.1945)		202'
System Type(s)		25%
Site LTAR		0.3

OTHER FACTORS (.1946):
SITE CLASSIFICATION (.1948): PS
EVALUATED BY: D Widenhouse
OTHER(S) PRESENT: S. Bracken

COMMENTS:

Updated February 2014

LEGEND

use the following standard abbreviations

LANDSCAPE POSITION	GROUP	SOIL TEXTURE	CONVENTIONAL .1955 LTAR*	LPP .1957 LTAR*	MINERALOGY/ CONSISTENCE	STRUCTURE
CC (Concave Slope)	I	S (Sand)	1.2 - 0.8	0.6 - 0.4	SEXP (Slightly Expansive)	G (Single Grain)
CV (Convex Slope)		LS (Loamy Sand)			EXP (Expansive)	M (Massive)
D (Drainage Way)						CR (Crumb)
DS (Debris Slump)	II	SL (Sandy Loam)	0.8 - 0.6	0.4 - 0.3		GR (Granular)
FP (Flood Plain)		L (Loam)				SBK (Subangular Blocky)
FS (Foot Slope)						ABK (Angular Blocky)
H (Head Slope)	III	Si (Silt)	0.6 - 0.3	0.3 - 0.15		PL (Platy)
L (Linear Slope)		SiCL (Silty Clay Loam)				PR (Prismatic)
N (Nose Slope)		CL (Clay Loam)				
R (Ridge)		SCL (Sandy Clay Loam)			**MOIST**	**WET**
S (Shoulder Slope)		SiL (Silt Loam)				
T (Terrace)					VFR (Very Friable)	NS (Non-sticky)
	IV	SC (Sandy Clay)	0.4 - 0.1	0.2 - 0.05	FR (Friable)	SS (Slightly Sticky)
		SiC (Silty Clay)			FI (Firm)	S (Sticky)
		C (Clay)			VFI (Very Firm v. Very Sticky)	VS (Very Sticky)
		O (Organic)	None	None	EFI (Extremely Firm)	NP (Non-plastic)
						SP (Slightly Plastic)
						P (Plastic)
						VP (Very Plastic)

*Adjust LTAR due to depth, consistence, structure, soil wetness, landscape, position, wastewater flow and quality.


NOTES

HORIZON DEPTH	In inches below natural soil surface
DEPTH OF FILL	In inches from land surface
RESTRICTIVE HORIZON	Thickness and depth from land surface
SAPROLITE	S(suitable) or U(unsuitable)
SOIL WETNESS	Inches from land surface to free water or inches from land surface to soil colors with chroma 2 or less - record Munsell color chip designation
CLASSIFICATION	S (Suitable), PS (Provisionally Suitable), or U (Unsuitable)

Evaluation of saprolite shall be by pits.

Long-term Acceptance Rate (LTAR): gal/day/ft^2

Show profile locations and other site features (dimensions, reference or benchmark, and North).

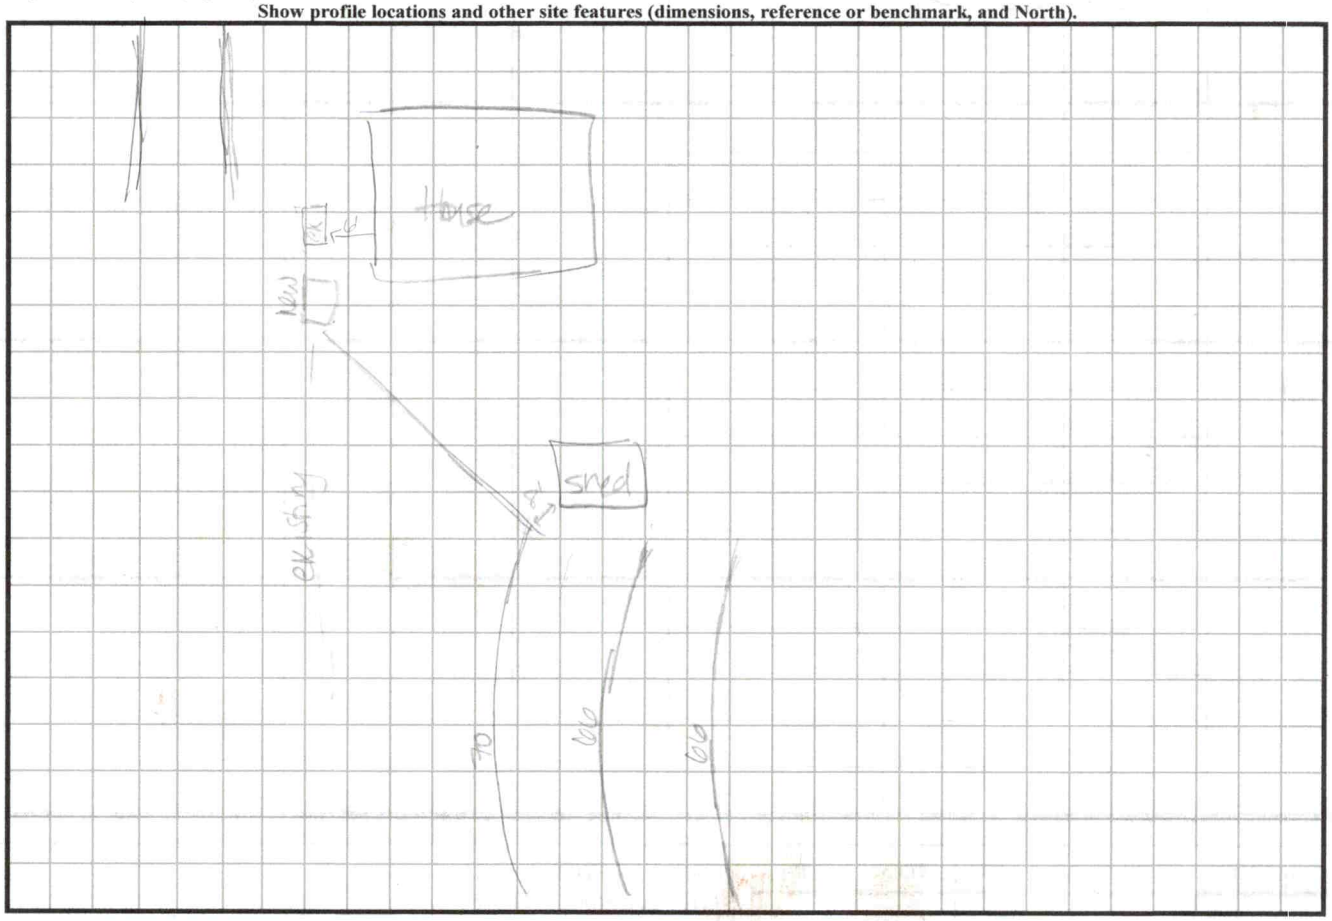

LEGEND

use the following standard abbreviations

LANDSCAPE POSITION	GROUP	SOIL TEXTURE	CONVENTIONAL .1955 LTAR*	LPP .1957 LTAR*	MINERALOGY/ CONSISTENCE	STRUCTURE
CC (Concave Slope) CV (Convex Slope) D (Drainage Way) DS (Debris Slump) FP (Flood Plain) FS (Foot Slope) H (Head Slope) L (Linear Slope) N (Nose Slope) R (Ridge) S (Shoulder Slope) T (Terrace)	I	S (Sand) LS (Loamy Sand)	1.2 - 0.8	0.6 - 0.4	SEXP (Slightly Expansive) EXP (Expansive)	G (Single Grain) M (Massive) CR (Crumb) GR (Granular) SBK (Subangular Blocky) ABK (Angular Blocky) PL (Platy) PR (Prismatic)
	II	SL (Sandy Loam) L (Loam)	0.8 - 0.6	0.4 - 0.3		
	III	Si (Silt) SiCL (Silty Clay Loam) CL (Clay Loam) SCL (Sandy Clay Loam) SiL (Silt Loam)	0.6 - 0.3	0.3 - 0.15		
					MOIST	**WET**
	IV	SC (Sandy Clay) SiC (Silty Clay) C (Clay)	0.4 - 0.1	0.2 - 0.05	VFR (Very Friable) FR (Friable) FI (Firm) VFI (Very Firm v. Very Sticky) EFI (Extremely Firm)	NS (Non-sticky) SS (Slightly Sticky) S (Sticky) VS (Very Sticky) NP (Non-plastic) SP (Slightly Plastic) P (Plastic) VP (Very Plastic)
		O (Organic)	None	None		

*Adjust LTAR due to depth, consistence, structure, soil wetness, landscape, position, wastewater flow and quality.


NOTES


HORIZON DEPTH	In inches below natural soil surface
DEPTH OF FILL	In inches from land surface
RESTRICTIVE HORIZON	Thickness and depth from land surface
SAPROLITE	S(suitable) or U(unsuitable)
SOIL WETNESS	Inches from land surface to free water or inches from land surface to soil colors with chroma 2 or less - record Munsell color chip designation
CLASSIFICATION	S (Suitable), PS (Provisionally Suitable), or U (Unsuitable)

Evaluation of saprolite shall be by pits.


Long-term Acceptance Rate (LTAR): gal/day/ft^2

Show profile locations and other site features (dimensions, reference or benchmark, and North).

 

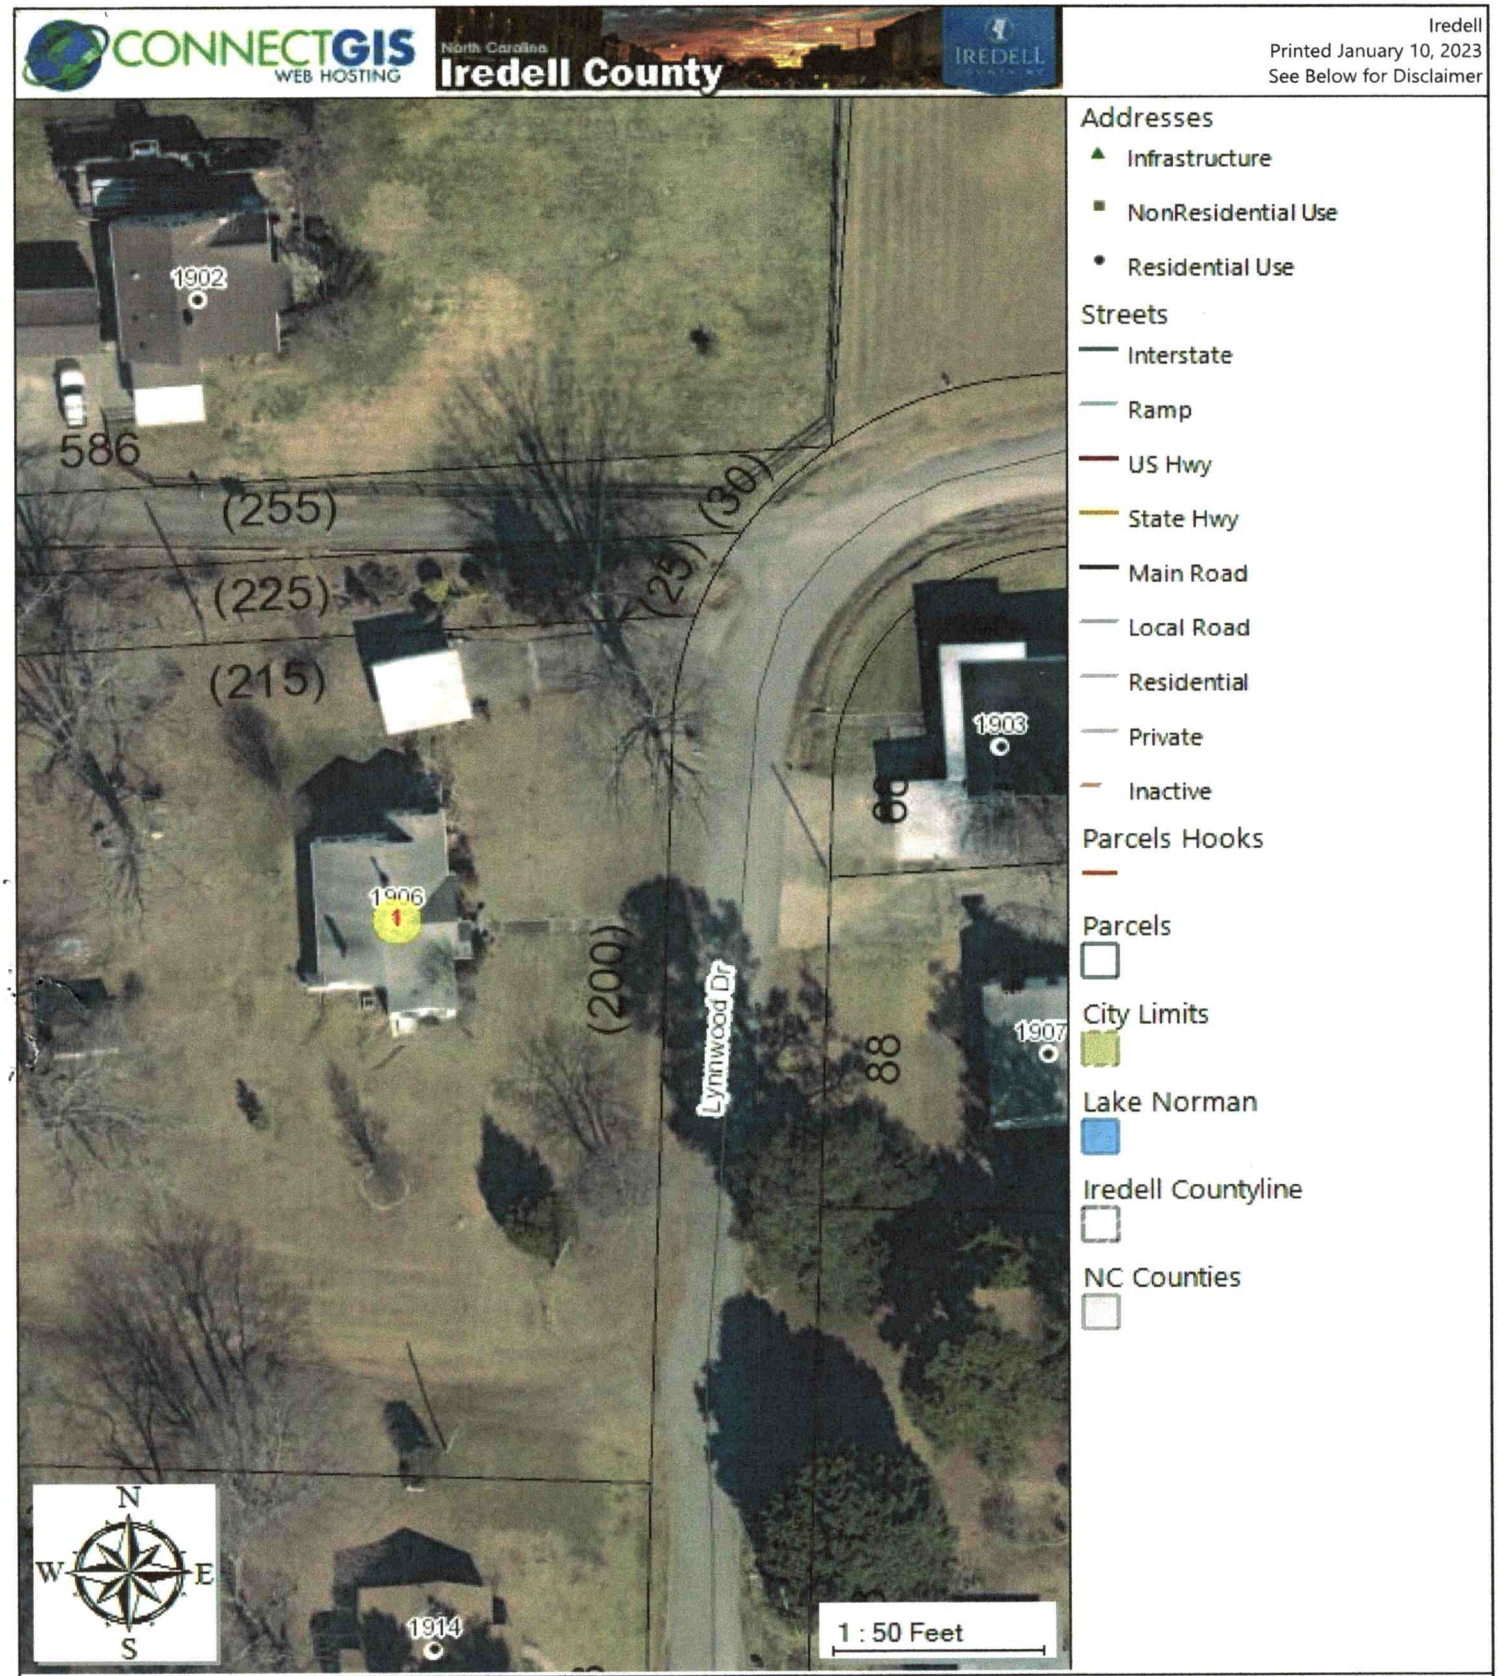

The maps prepared for this website are generated from recorded deeds, plats, and other public records. Users of these maps are hereby notified that the information provided herein should be verified. Iredell County assumes no legal responsibilities for any of the information contained on this site. Users are advised that the use of any of this information is at their own risk. All maps on this site were prepared using a 1000â€™ Grid based upon the North Carolina State Plane Coordinate System from the 1983 North American Datum. The delinquent real property tax overlay is updated monthly. The information presented is not intended to be used or relied upon as official notice of tax liens. For additional information regarding delinquent taxes, contact the Iredell County Tax Collector's Office.

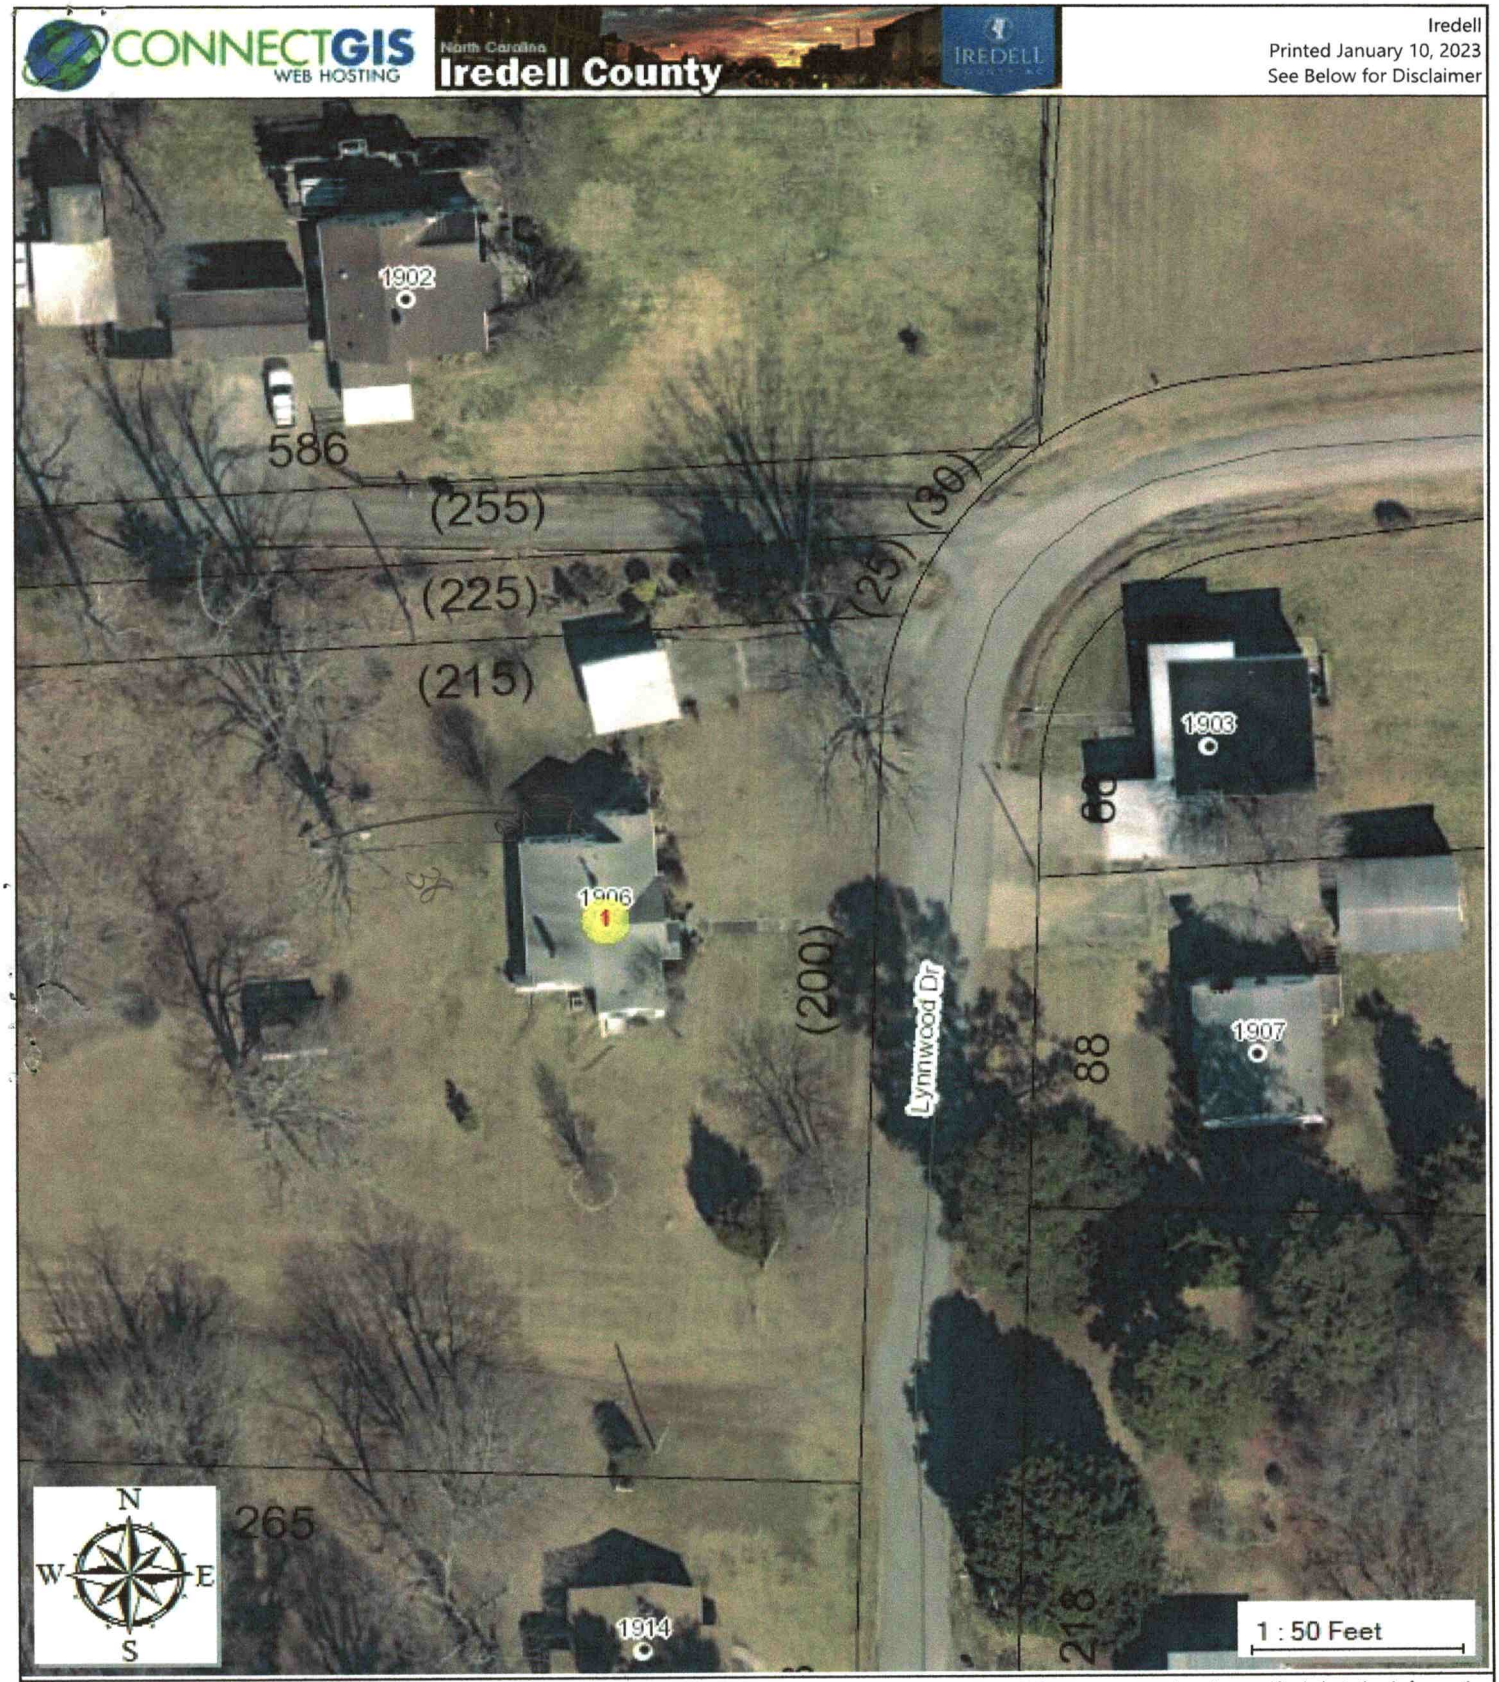

The maps prepared for this website are generated from recorded deeds, plats, and other public records. Users of these maps are hereby notified that the information provided herein should be verified. Iredell County assumes no legal responsibilities for any of the information contained on this site. Users are advised that the use of any of this information is at their own risk. All maps on this site were prepared using a 1000â€™ Grid based upon the North Carolina State Plane Coordinate System from the 1983 North American Datum. The delinquent real property tax overlay is updated monthly. The information presented is not intended to be used or relied upon as official notice of tax liens. For additional information regarding delinquent taxes, contact the Iredell County Tax Collector's Office.

PERMIT SNAPSHOT REPORT OSWP-2022-12518 FOR IREDELL COUNTY

Permit Type: Environmental Health OSWP
Project:
App Date: 12/29/2022

Work Class: EH Septic Improvement Permit Repair
District: Statesville
Exp Date: NOT AVAILABLE

Status: PRIORITY PERMIT
Square Feet: 0.00
Completed: NOT COMPLETED

Valuation: $0.00
Assigned To: Wieberg, Danielle
Approval Expire Date:

Description: PRIORITY : REPAIR PERMIT: Tank is collapsing. Will repair with a tank replacement. NEED REPLACED AS SOON AS POSSIBLE (REQUESTED DANIELLE) THIS LOCATIOHOME OWNER WANTS TO BE NOTIFIED WHEN INSPECTOR IS GOING TO THE LOCATION: AMY 919-349-0768 THIS IS ACROSS FROM OSWP-2022-12520 WHICH ALSO IS A TANK REPLACEMENT.

Parcel: 4733766912.000 Main

Address: 1906 Lynnwood Dr Main
Statesville, NC 28677

Zone: R-5MFM(R-5MFM)
R-8M(Medium Density Single-Family/Mar

Applicant/Authorized Agent
Cameron Foust
518 lakeview drive
Mcadenville, NC 28101
Business: (704) 502-1263

Property Owner
AUGUSTINE PROPERTIES
LLC
AMY AUGUSTINE
Mobile: (919) 349-0768

Permit Custom Fields

How is your site plan being submitted	Custom Site Plan	Does the site contain any jurisdictional wetlands	No	Non-domestic Sewage Generated	No
Other Public Agency	Yes	Maximum Number of Bedrooms	3	Number of Occupants	6
Foundation Type	Crawl Space Foundation	Water Supply	City Water	Desired Septic System Type	Conventional (most common)
If other septic system type, please explain		Additional Unique Setbacks Apply	No		

Attachment File Name	Added On	Added By	Attachment Group	Notes
Signature_Cameron_Foust_12/30/2022.jpg	12/29/2022 22:24	Foust, Christa		Uploaded via CSS
Authorize 1906 Lynnwood_v1.pdf	01/09/2023 16:31	Comeaux, Debra	Available Online	Authorize to Act as Agent
Site Plan 1906 Lynnwood_v1.pdf	01/09/2023 16:32	Comeaux, Debra	Available Online	Site Plan

Invoice No.	Fee	Fee Amount	Amount Paid
NOT INVOICED	Existing System Septic Repair Permit	$150.00	$0.00
	Total for Invoice NOT INVOICED	$150.00	$0.00
	Grand Total for Permit	**$150.00**	**$0.00**

Workflow Step / Action Name	Action Type	Start Date	End Date
Application Completeness Check v.1		01/09/2023 16:34	01/09/2023 16:34
Confirm application complete v.1	Generic Action		01/09/2023 16:34
Lot Readiness Verification v.1			
~~OSWP Septic Preliminary Site Visit v.1~~	Inspection		01/09/2023 16:35
OSWP Site Evaluation v.1	Inspection		
~~Zoning Review v.1~~			01/09/2023 16:35
~~Issue Invoice v.1~~	Generic Action		01/09/2023 16:35
~~Statesville Zoning Approval v.1~~	Task		01/09/2023 16:35
~~Fees Paid v.1~~	Generic Action		01/09/2023 16:35
Assign v.1			
Case Assigned v.1	Generic Action		
Permit Ready v.1			
Issue Permit v.1			
Issue Invoice v.1	Generic Action		
Fees Paid v.1	Generic Action		