IREDELL COUNTY HEALTH DEPARTMENT

Statesville Phone TR 3-7271 Mooresville Phone No. 664-5281

PERMIT TO INSTALL SEPTIC TANK

Permit No. 196 Permit Date 10-11 1972

1328 11th ST

Owner Mrs. Leon Delsan Address Statesville, N.C.

Installed By Herman Gibson Address Statesville, N.C.

Location of Property


1328 Eleventh St.

Tank		Capacity		Length of Lines		Fixtures	
Block	( )	1000	(✓)	225'	(✓)	No. of Baths	(1)
Precast	(✓)	1250	( )	250'	( )	Dishwasher	( )
		1500	( )	Other		Garbage Grdr.	( )
		Other				Other	

NOTIFY HEALTH DEPARTMENT AT LEAST EIGHT HOURS BEFORE TANK IS TO BE INSPECTED.

Final Inspection 10-11 1972 Approved (✓) Disapprcved ( )

Remarks

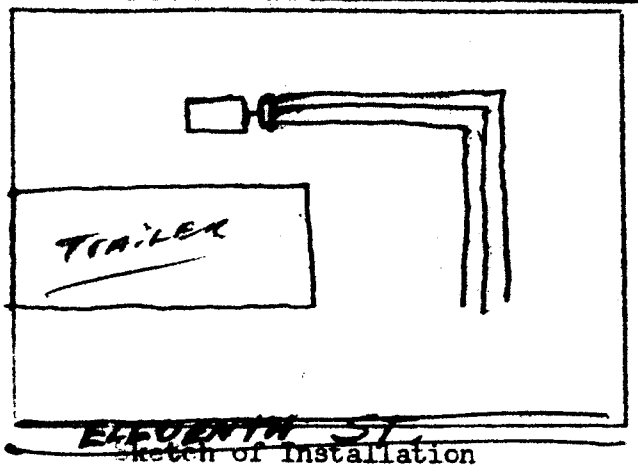

Sketch of Installation

This property to Lean for city Sewer.

Glenn Todd Jr

Sanitarian