IREDELL COUNTY HEALTH DEPARTMENT - *ENVIRONMENTAL HEALTH* ☑ STATESVILLE OFFICE 704-878-5305 ☐ MOORESVILLE OFFICE 704-664-5281

IMPROVEMENT PERMIT / AUTHORIZATION TO CONSTRUCT / OPERATION PERMIT / EXISTING SYSTEM INSPECTION

PERMIT # 166352 PIN # 4733-80-0613 DATE 7 June 2011

OWNER Johnny Wilkerson APPLICANT: Tim Abee PHONE: Home/Cell # (336) 492-2089 Business #

SITE ADDRESS 151 Cumberland Rd. Statesville OWNER / APPLICANT ADDRESS

SITE DIRECTIONS Shelton Ave TL Cumberland Rd. on LH. corner of Bluebird

SUBDIVISION Chalet Estates BLOCK / SECTION LOT # 10 LOT AREA 0.6ac. DESIGN FLOW 240g/d L.T.A.R. 0.3g/ft²/d

Septic Tank Exist. Gallons: STB Date
Pump Tank Gallons: P T Date
Pump Make Model Serial #
No. Nitrification Fields: 1 No. Lines 1 Linear Feet 50
Trench Width 36" Max. Trench Bottom Depth 36" Gravel Depth AR


☑ New System ☐ Repair ☐ Expansion System Type I II (III) V V VI
System Description: 25% Reduction
Repair System Description: ~~20~~ 50% Reduction - CAP
Maintenance Agreement Required ☐ YES ☒ NO
☒ GRAVITY ☐ PRESSURE

☑ Residence No. Bedrooms 2
☐ Business No. Persons
☐ Other No. Employees
☐ Slab ☑ Crawl Space
☐ Basement w/plumbing ☐ Basement w/o plumbing

Water Supply: ☑ Private ☐ Public ☐ Community

Comments / Conditions: Cut-off old lines 10' from prop. line. Add 50' 25% Reduction system

INITIAL SITE SKETCH

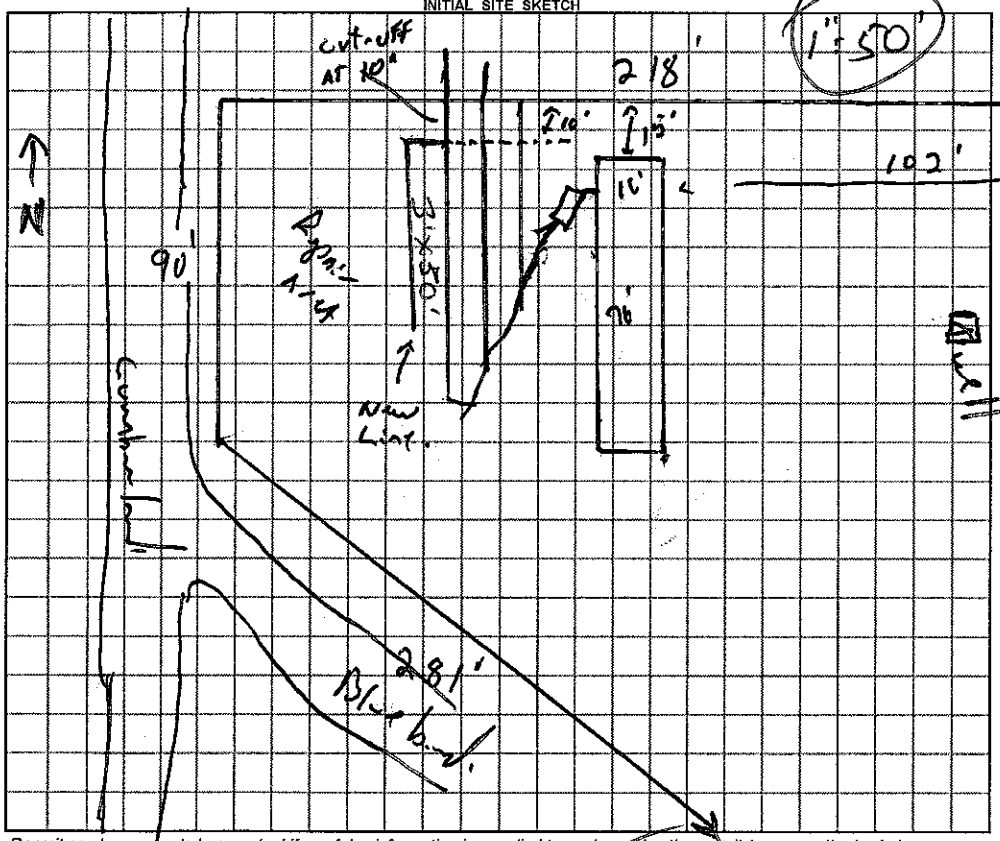

AS BUILT SKETCH

Install As Drawn

Permit can be suspended or revoked if any false information is supplied toward securing the permit / any unauthorized changes are made to the site / any unauthorized changes are made in the installation of the system.

☐ *IMPROVEMENT PERMIT with plat valid without expiration.* ☑ *IMPROVEMENT PERMIT with plat valid without expiration. Site plan valid 60 mo.* ☑ *AUTHORIZATION TO CONSTRUCT* valid for period equal to IMPROVEMENT PERMIT--not to exceed 60 mo.

Owner / Applicant Signature: Tim Abee Date 6/7/11
IMPROVEMENT PERMIT by: REHS Date 7 JUN 11
AUTHORIZATION TO CONSTRUCT by: REHS Date 7 Jun 11

Installed by: Tim Abee
OPERATION PERMIT by: REHS Date 8 June 11
Existing System Inspected by: REHS Date

YOU SHOULD CONTACT A LOCATOR SERVICE PRIOR TO ANY EXCAVATION

White Copy – Environmental Health YELLOW COPY (Final) Owner / Applicant PINK COPY (Initial) Owner / Applicant