IREDELL COUNTY HEALTH DEPARTMENT

STATESVILLE 704-878-5305 MOORESVILLE 704-664-5281

IMPROVEMENT PERMIT / AUTHORIZATION TO CONSTRUCT / OPERATION PERMIT / EXISTING SYSTEM INSPECTION

PERMIT# 87040 PIN# 4732895620 DATE 1-3-00

OWNER OR CONTRACTOR Bradley Troutman PHONE: Business 876 6847 Home

ADDRESS 150 Blue bird Lane Statesville N.C.

LOCATION US 21 South To Cumberland To Bluebird 1/4 mi Rt.

SUBDIVISION BLOCK / SECTION LOT LOT AREA .57 acres SITE CLASS PS DESIGN FLOW 360 L.T.A.R. .3

Septic Tank: 1000 Gallons; STB 312 Date 12/10/99
Pump Tank: Gallons; PT Date
Pump Make: Model Serial No.
Nitrification Field: No Fields 1 Square Feet 900 Linear Feet 300
No Lines 5 Trench Width 36" Max Trench Bottom Depth 36" Gravel Depth N/A

☑ New System ☐ Repair System Type: I, II, III, IV, V, VI
System Description: Gravity 25% Red.
Repair System Description: Pump To Panels
Maintenance Agreement Required: ☐ Yes ☑ No


☐ House/Mod. Home No. Bedrooms 3
☐ Mobile Home No. Bathrooms 2
☐ Business No. Employees
☐ Other
☐ Slab ☑ Crawl Space ☐ Basement w/plumbing ☐ Basement wo/plumbing

Water Supply: ☑ Individual ☐ Public ☐ Community


Comments./Conditions:

Comments./Conditions.

INITIAL SITE SKETCH

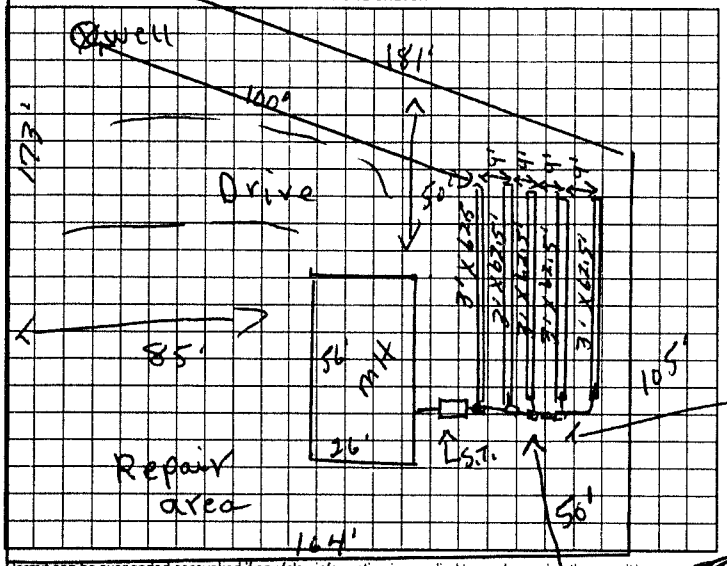

AS BUILT SKETCH

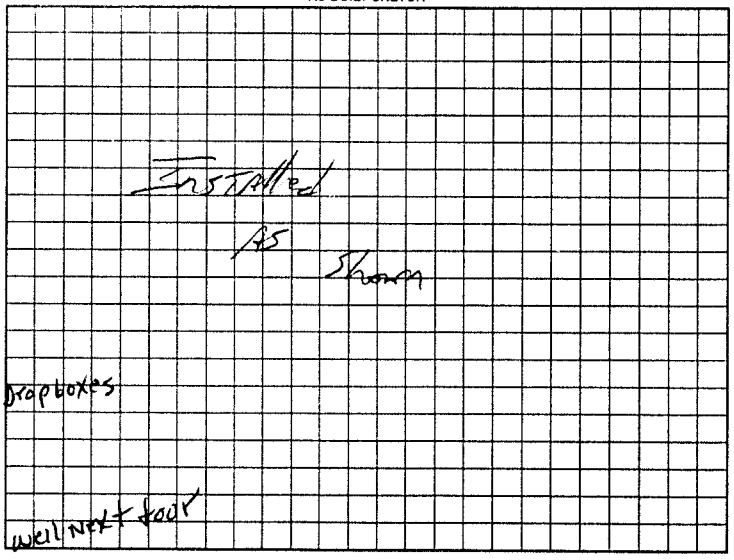

Blue bird

Permit can be suspended or revoked if any false information is supplied toward securing the permit/any unauthorized changes are made to the site/any unauthorized changes are made in the installation of the system. Improvement Permit with plat valid without expiration. Improvement Permit with site plan valid for sixty months. Authorization to Construct is valid for a period equal to that of Improvement Permit – not to exceed sixty months.

Signed: Ben Stikeleather 1-4-00 date

Improvement Permit by: R. C. Moore date 1-3-00

Authorization to Construct by: R. C. Moore date 1-3-00

Installed by: Tucker Brothers

Operation Permit by: Jo Potter date Feb 11 2000

Existing System Inspection by: date

HEALTH DEPT. COPY: WHITE OWNER COPY (FINAL): YELLOW OWNER COPY (INITIAL): PINK