72897

IREDELL COUNTY HEALTH DEPARTMENT

STATESVILLE 704-878-5305 MOORESVILLE 704-664-5281

IMPROVEMENT PERMIT / AUTHORIZATION TO CONSTRUCT / OPERATION PERMIT / EXISTING SYSTEM INSPECTION

PERMIT# 09905-CITY PIN# 4733-92-9414 DATE 9-21-00

OWNER OR CONTRACTOR OAKWOOD HOMES PHONE: Business 528-4516 Home

ADDRESS 1012 CHARLOTTE HWY, TROUTMAN, NC 28166

LOCATION US 21 / NC 115 SOUTH, TL NOLA LANE, 1ST LOT ON LEFT

SUBDIVISION BLOCK / SECTION LOT LOT AREA ~3.22 ACRES SITE CLASS PS DESIGN FLOW 360 L.T.A.R. 0.4 GPD/FT²

Septic Tank: 1000 Gallons; STB 794 Date 6-26-00
Pump Tank: Gallons; PT Date
Pump Make: Model Serial No.
Nitrification Field: No Fields 1 Square Feet 900 Linear Feet 300'
No Lines SIX Trench Width 36" Max Trench Bottom Depth 36" Gravel Depth 12"

☑ New System ☐ Repair System Type: I ☐ II. III. IV. V. VI
System Description: CONVENTIONAL GRAVITY
Repair System Description: CONV. / GRAVITY
Maintenance Agreement Required: ☐ Yes ☑ No
☐ Slab ☑ Crawl Space ☐ Basement w/plumbing ☐ Basement wo/plumbing


☐ House/Mod. Home No. Bedrooms 3
☑ Mobile Home No. Bathrooms 2
☐ Business No. Employees
☐ Other

Water Supply: ☑ Individual ☐ Public ☐ Community WELL


Comments/Conditions: KEEP SYSTEM MINIMUM 100 FEET FROM WELL

Comments/Conditions: POTENTIAL WELL SITE

INITIAL SITE SKETCH

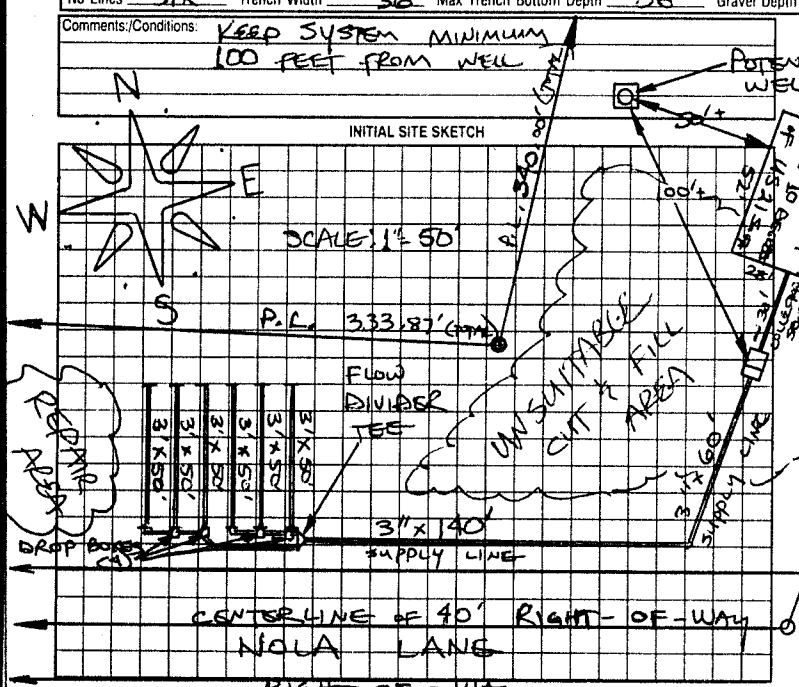

AS BUILT SKETCH

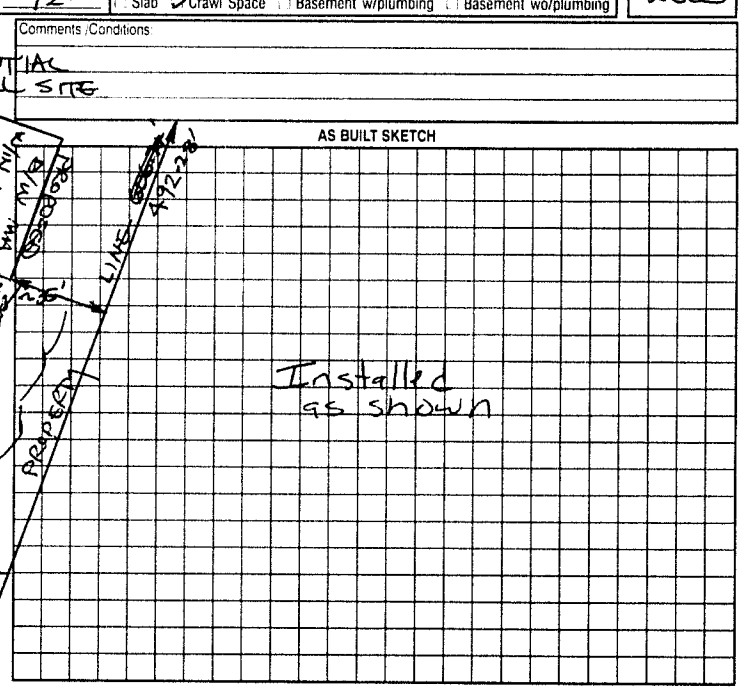

Permit can be suspended or revoked if any false information is supplied toward securing the permit/any unauthorized changes are made to the site/any unauthorized changes are made in the installation of the system. Improvement Permit with plat valid without expiration. Improvement Permit with site plan valid for sixty months. Authorization to Construct is valid for a period equal to that of Improvement Permit – not to exceed sixty months.

Signed: [signature] date 9-21-00 Installed by: Tucker's Grading

Improvement Permit by: STEVE HEDRICK date 9-21-00 Operation Permit by: [signature] date 10-17-00

Authorization to Construct by: STEVE HEDRICK date 9-21-00 Existing System Inspection by: date

HEALTH DEPT. COPY WHITE OWNER COPY (FINAL) YELLOW OWNER COPY (INITIAL) PINK