IREDELL COUNTY HEALTH DEPARTMENT

Statesville Phone TR 3-7271 Mooresville Phone NO 3-1271

PERMIT TO INSTALL SEPTIC TANK

Permit NO. _____ Permit Date Sept 6 1965

Owner L.E. Laws - Clyde Hoke Bldr. Address R7

Installed By C Hoke Address R7


Location of Property Hardwood S/D #2 S - Lot #19 on circle.

Tank		Capacity		Length of Lines		Fixtures	
Block	( )	1000	( )	225'	( )	No. of Baths	(2)
Precast	(✓)	1250	( )	250'	(✓)	Dishwasher	( )
		1500	( )	Other _____	( )	Garbage Grdr.	( )
		Other _____				Other _____	

NOTIFY HEALTH DEPARTMENT AT LEAST EIGHT HOURS BEFORE TANK IS TO BE INSPECTED.

Final Inspection _____ 19__ Approved ( ) Disapproved ( )

Remarks City water -

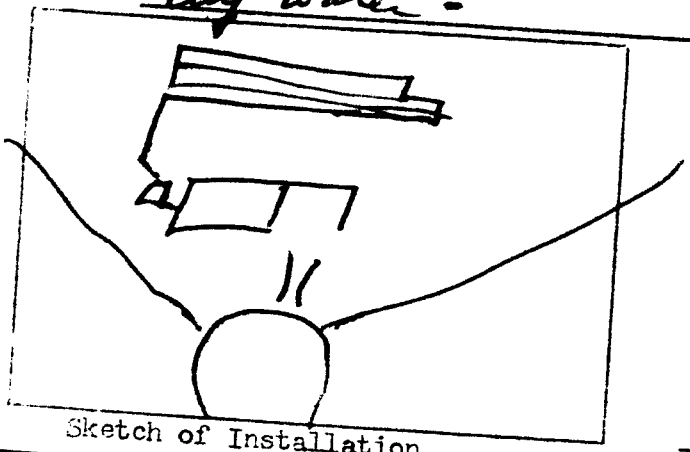

Sketch of Installation

RWJ

Sanitarian