IREDELL COUNTY HEALTH DEPARTMENT

Statesville Phone TR 3-7271 Mooresville Phone NO 3-1271

PERMIT TO INSTALL SEPTIC TANK

Permit NO. _____ Permit Date Mar. 7 19 66

Owner Clyde Hobe Belden Address R7

Installed By C Hobe Address R7


Location of Property lot # 22 Knollwood S/D off 21 South.

Tank		Capacity		Length of Lines		Fixtures	
Block	( )	1000	(+)	225'	(+)	No. of Baths	(2)
Precast	(+)	1250	( )	250'	( )	Dishwasher	( )
		1500	( )	Other _____		Garbage Grdr.	( )
		Other _____				Other _____	

NOTIFY HEALTH DEPARTMENT AT LEAST EIGHT HOURS BEFORE TANK IS TO BE INSPECTED.

Final Inspection _____ 19__ Approved ( ) Disapproved ( )

Remarks city water - Step - wooded

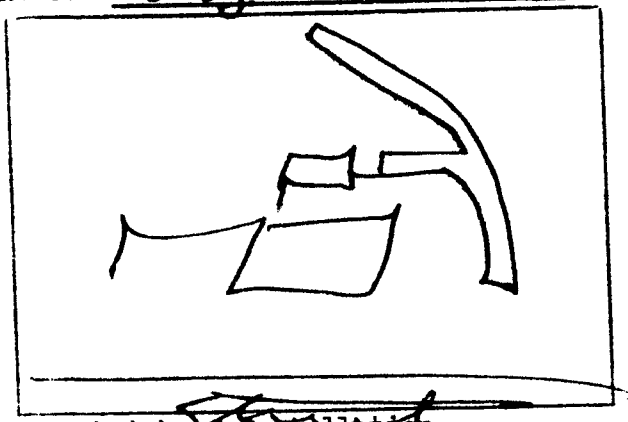

Sketch of Installation

Sanitarian