3 PP

IREDELL COUNTY HEALTH DEPARTMENT - *ENVIRONMENTAL HEALTH* ☑ STATESVILLE OFFICE 704-878-5305 ☐ MOORESVILLE OFFICE 704-664-5281

IMPROVEMENT PERMIT / AUTHORIZATION TO CONSTRUCT / OPERATION PERMIT / EXISTING SYSTEM INSPECTION

PERMIT # Repair PIN # 4733-86-1102 DATE 16th November 2011

OWNER Robert L. Gordin SR. APPLICANT: Robert Gordin, JR. PHONE: Home/Cell # (704) 881-1422 Business #

SITE ADDRESS 186 Wallace Springs Rd. Stat. OWNER / APPLICANT ADDRESS

SITE DIRECTIONS Corner of Wallace Springs Rd. & Carver Ave.

SUBDIVISION BLOCK / SECTION LOT # LOT AREA 0.27 ac. DESIGN FLOW 360 gpd L.T.A.R. 0.2 gal/sq ft

Septic Tank Exist. 1000 Gallons: STB 760 Date 3-13-17
Pump Tank 1000 Gallons: PT 363 Date 3-13-17
Pump Make Model Serial #
No. Nitrification Fields: 1 No. Lines 4 Linear Feet 300
Trench Width 36" Max. Trench Bottom Depth 36" Gravel Depth NA

☐ New System ☑ Repair ☐ Expansion System Type I II III IV V VI
System Description:
Repair System Description: 25% Reduction - Pressure manifold
Maintenance Agreement Required ☐ YES ☒ NO
☐ GRAVITY ☑ PRESSURE


☑ Residence No. Bedrooms 3
☐ Business No. Persons
☐ Other No. Employees
☐ Slab ☐ Crawl Space
☑ Basement w/plumbing ☐ Basement w/o plumbing

Water Supply: ☐ Private ☐ Public ☑ Community


Comments / Conditions
* Easement Attached. / Replace Tee in Septic tank with filter tee.

Pump specs 30gpm @ 30' TDH
2" sch 40 pvc supply line
4" sch 40 pvc manifold

INITIAL SITE SKETCH

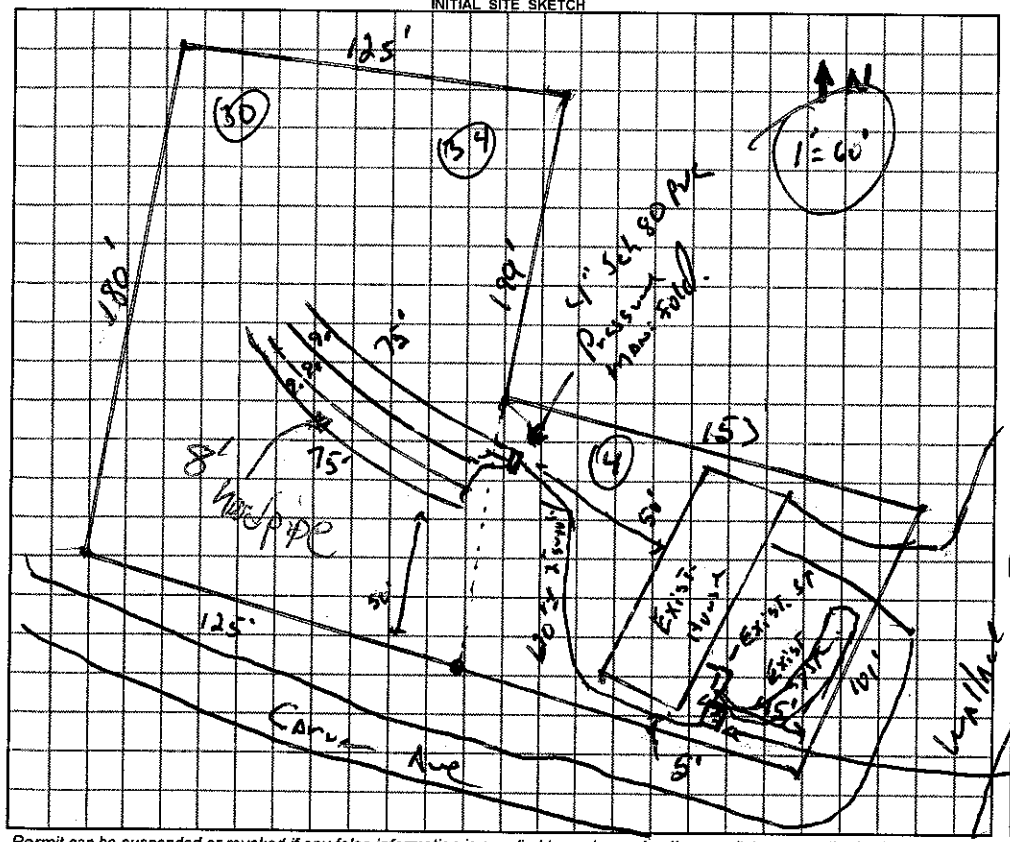

AS BUILT SKETCH

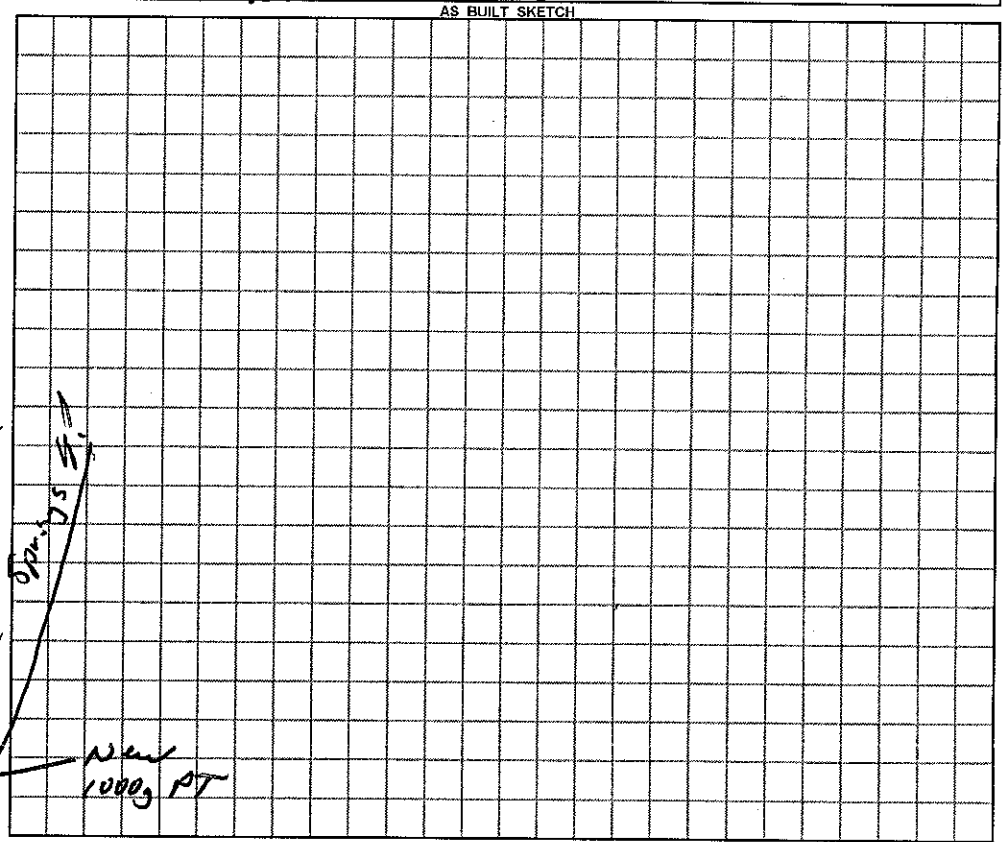

Permit can be suspended or revoked if any false information is supplied toward securing the permit / any unauthorized changes are made to the site / any unauthorized changes are made in the installation of the system.

☐ *IMPROVEMENT PERMIT with plat valid without expiration.* ☑ *IMPROVEMENT PERMIT with ~~plat valid without expiration.~~ site plan valid 60 mo.* ☑ *AUTHORIZATION TO CONSTRUCT* valid for period equal to IMPROVEMENT PERMIT–not to exceed 60 mo.

Owner / Applicant Signature: Date Installed by:

IMPROVEMENT PERMIT by: REHS Date 16Nov.11 OPERATION PERMIT by: REHS Date 3-19-12

AUTHORIZATION TO CONSTRUCT by: REHS Date 16Nov.11 Existing System Inspected by: REHS Date

YOU SHOULD CONTACT A LOCATOR SERVICE PRIOR TO ANY EXCAVATION

White Copy – Environmental Health YELLOW COPY (Final) Owner / Applicant PINK COPY (Initial) Owner / Applicant