Not on Book

IREDELL COUNTY HEALTH DEPARTMENT

Statesville Phone TR 3-7271 Mooresville Phone NO 3-1271

PERMIT TO INSTALL SEPTIC TANK

Permit No. _____ Permit Date 5-1 19 70

Owner U.L. Icenhower Builders Address Statesville N.C.

Installed By Lacky Brothers Const Co Address Stony Point Rt. 1 N.C.


Location of Property Wallace Spring Road. Turn off at the end of Bulevard to the Right. about ½ mile on Right.

| Tank | | Capacity | | Length of Lines | | Fixtures | |
|---|---|---|---|---|---|---|---|
| Block | ( ) | 1000 | (✓) | 225' | (✓) | No. of Baths | (2) |
| Precast | (✓) | 1250 | ( ) | 250' | ( ) | Dishwasher | ( ) |
| | | 1500 | ( ) | Other _____ | | Garbage Grdr. | ( ) |
| | | Other _____ | | | | Other _____ | |

NOTIFY HEALTH DEPARTMENT AT LEAST EIGHT HOURS BEFORE TANK IS TO BE INSPECTED.

Final Inspection _____ 19__ Approved ( ) Disapproved ( )

Remarks Not a good Place for Tank Line.

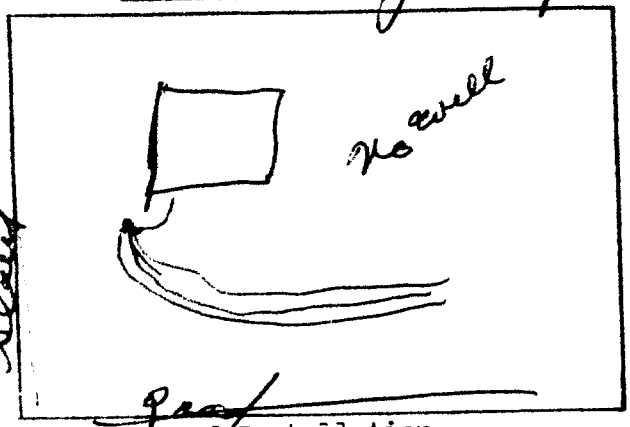


Sketch of Installation

Sanitarian