IREDELL COUNTY HEALTH DEPARTMENT

Statesville Phone TR 3-7271 Mooresville Phone NO 3-1271

PERMIT TO INSTALL SEPTIC TANK

Permit NO. _____ Permit Date MARCH 30 1961

Owner GEORGE TATUM (COLORED) Address STATESVILLE, N.C

Installed By SELF Address _____


Location of Property OUT WALLACE SPGS RD. JUST BEHIND OLD AMERICAN LEGION HUT -

Tank		Capacity		Length of Lines		Fixtures	
Block	(✓)	800	( )	150'	( )	No. of Baths	(1)
Precast	( )	900	( )	175'	( )	Dishwasher	( )
		1000	( )	200'	( )	Garbage Grdr.	( )
		1100	(✓)	225'	(✓)	Auto-Washer	( )
		1200	( )	250'	( )	Other	_____
		Other	_____	Other	_____		

NOTIFY HEALTH DEPARTMENT AT LEAST EIGHT HOURS BEFORE TANK IS TO BE INSPECTED.

Final Inspection MARCH 30 1961 Approved (✓) Disapproved ( )

Remarks DRIVE STREET

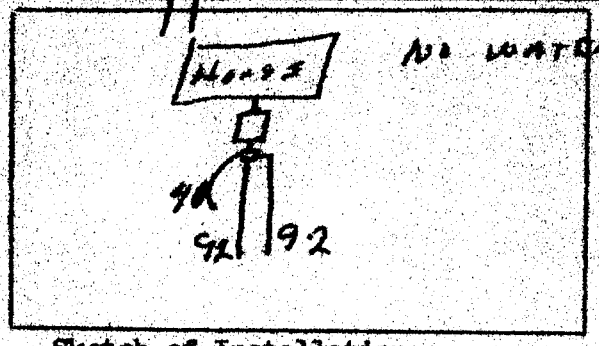

Sketch of Installation

NO WATER ON PROPERTY
DUG BY HAND

Raford A. Thomas

Sanitarian