IREDELL COUNTY HEALTH DEPARTMENT

Statesville Office (704) 878-5305 Mooresville Office (704) 660-3625 PERMIT # 20187

IMPROVEMENT PERMIT / AUTHORIZATION TO CONSTRUCT / OPERATION PERMIT / EXISTING SYSTEM

PIN # 4733866164

APPLICANT: Ronnie Broome APPLICANT ADDRESS: P.O. Box 248 Troutman NC

SITE ADDRESS: 162 Ridgewood Ln Statesville NC 28677 PHONE: 704-902-2057 ALT. PHONE: 704-657-3141

SITE DIRECTIONS: 115 S T/R Tara Sha T/R Ridgewood house at end

SUBDIVISION: Knollwood SECTION: N/A LOT # 48 LOT AREA: DESIGN FLOW: 360 L.T.A.R.: N/A

Septic Tank	EX	(gal)	STB	EX	Date	EX	☐ New System	☐ Repair	☐ Expansion	System Type: I II III IV V VI	
Pump Tank	N/A	(gal)	PT	N/A	Date	N/A	System Description:	Existing			
Pump Make	N/A	Model		EX	Serial #	EX	Repair System Description:	Existing			
# Nitrification Fields	1	# Lines		EX	Linear Ft:	EX	Maintenance Agreement Required:	☐ YES	☒ NO		
Trench Width	EX	Max. Trench Bottom Depth		EX	Gravel Depth	EX	☒ GRAVITY	☐ PRESSURE			

☒ Residence ☐ Business ☐ Other ☐ Slab ☐ Basement w/plumbing

No. Bedrooms 3 No. Persons 6 No. Employees ☒ Crawl Space

Water Supply: ☒ Private ☐ Public ☐ Community


☐ Basement w/o plumbing

Comments / Conditions:

All building foundations must be 55' from any STS and 525' from any well.

INITIAL SITE SKETCH

AS BUILT SKETCH

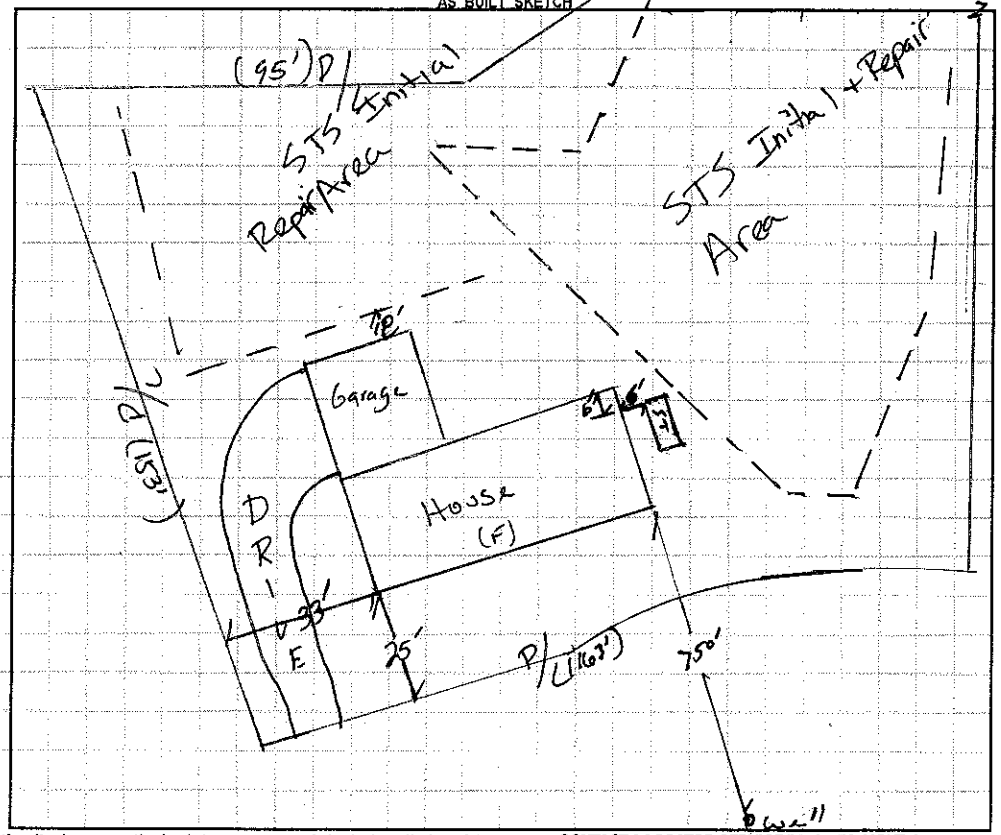

Permit can be suspended or revoked if any false information is supplied toward securing the permit / any unauthorized changes are made to the site / any unauthorized changes are made in the installation of the system. **CONTACT A LOCATOR SERVICE PRIOR TO ANY EXCAVATION**

☐ **IMPROVEMENT PERMIT** *with plat valid without expiration.* ☐ **IMPROVEMENT PERMIT** *with site plan valid for 60 mos.* ☐ **AUTHORIZATION TO CONSTRUCT** *valid for period equal to IMPROVEMENT PERMIT--not to exceed 60 mo.*

Owner / Applicant Signature: Ronnie E. Broome Date: 2/28/14 Installed by:

IMPROVEMENT PERMIT by: Date: OPERATION PERMIT by: Date:

AUTHORIZATION TO CONSTRUCT by: Date: Existing System Inspected by: Date: 02/27/14

Health Dept. Copy - WHITE Applicant (Final Approval) - YELLOW Applicant (Conditional Approval) - PINK