IREDELL COUNTY HEALTH DEPARTMENT

STATESVILLE 704-878-5305 MOORESVILLE 704-664-5281

IMPROVEMENT PERMIT / AUTHORIZATION TO CONSTRUCT / OPERATION PERMIT / EXISTING SYSTEM INSPECTION

PERMIT # REPAIR PIN # 4733-87-4061 DATE FEBRUARY 25, 2009

OWNER or APPLICANT ALBERTO SANTIBANEZ PHONE: Business Home:

OWNER or APPLICANT ADDRESS 139 WALLACE SPRINGS ROAD STATESVILLE, NC 28677

LOCATION / DIRECTIONS WILSON LEE BLVD to WALLACE SPRINGS ROAD 1¼ MI, LOT ON LEFT AT BOX # 139

SUBDIVISION BLOCK / SECTION LOT # LOT AREA 0.12 Ac. DESIGN FLOW 240 L.T.A.R. 0.25 GAD/FT²

Septic Tank EXISTING Gallons: STB Date

Pump Tank Gallons: P T Date

Pump Make Model Serial #

Nitrification Field No Fields 1 No Lines 1 Linear Feet 72'

Trench Width 36" Max. Trench Bottom Depth ~48" +/- Gravel Depth 24"

☐ New System ☑ Repair ☐ Expansion System Type I (II) III IV V VI

System Description:

Repair System Description: CONVENTIONAL GRAVITY

Maintenance Agreement Required ☐ YES ☑ NO 24" STONE

☐ GRAVITY ☐ PRESSURE

☑ Residence No. Bedrooms 2

☐ Business No. Persons

☐ Other No. Employees

☐ Slab ☐ Crawl Space


☐ Basement w/plumbing ☑ Basement w/o plumbing

Water Supply: ☐ Private ☐ Public ☐ Community

Comments / Conditions

Comments / Conditions

INITIAL SITE SKETCH

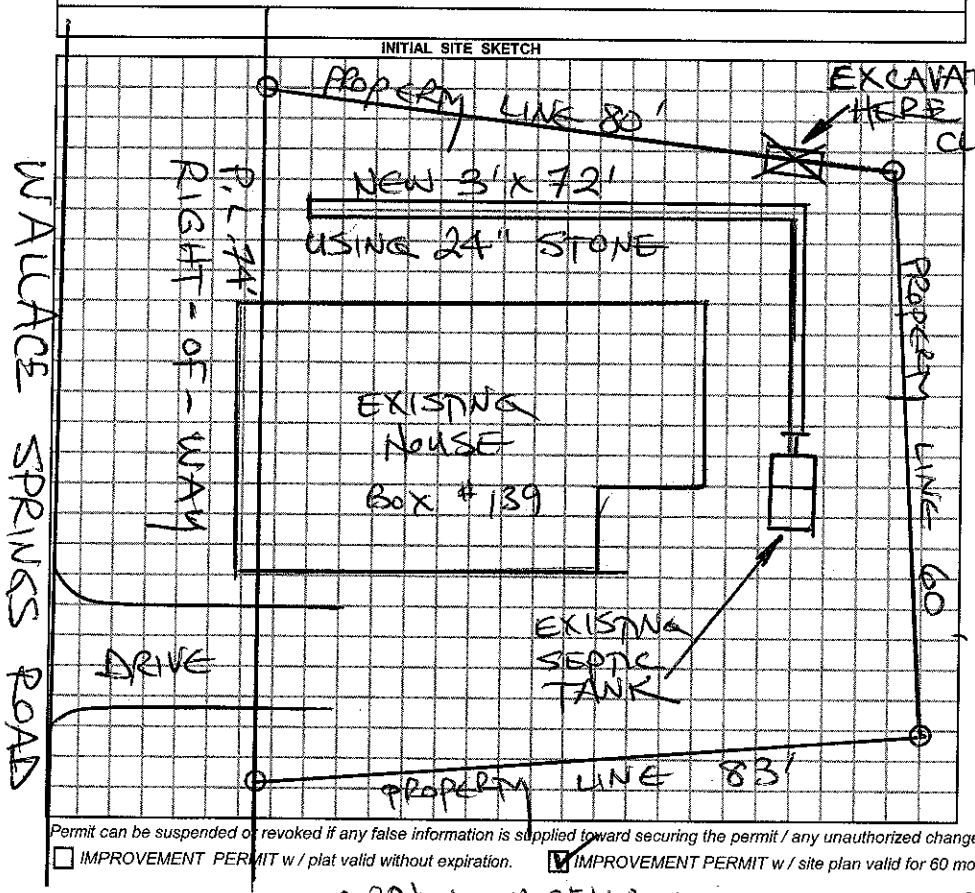

AS BUILT SKETCH

EXISTING DRAINLINES PACK WITH FRESH CLEAN SOIL.

SYSTEM REPAIRED ACCORDING TO INITIAL SITE SKETCH

Permit can be suspended or revoked if any false information is supplied toward securing the permit / any unauthorized changes are made to the site / any unauthorized changes are made in the installation of the system.

☐ *IMPROVEMENT PERMIT w / plat valid without expiration.* ☑ *IMPROVEMENT PERMIT w / site plan valid for 60 mos.* ☐ *AUTHORIZATION TO CONSTRUCT valid for period equal to IMPROVEMENT PERMIT-not to exceed 60 mo.*

Owner / Applicant Signature: MARIBEL ARELLANO Date 2-25-09

Improvement Permit by: STEVE HEDRICK Date 2/25/09

Authorzation to Construct by: STEVE HEDRICK Date 2/25/09

YOU SHOULD CONTACT A LOCATOR SERVICE PRIOR TO ANY EXCAVATION.

Installed by: A-1 BACKHOE

Operation Permit by: STEVE HEDRICK Date: 3-6-09

Existing System Inspected by: Date:

WHITE COPY Environmental Health YELLOW COPY (Final) Owner / Applicant PINK COPY (Initial) Owner / Applicant