IREDELL COUNTY HEALTH DEPARTMENT

STATESVILLE 704-878-5305 MOORESVILLE 704-664-5281

IMPROVEMENT PERMIT / CERTIFICATE OF COMPLETION / OPERATION PERMIT / EXISTING SYSTEM INSPECTION

PROPERTY DESCRIPTION NO. 67736 DATE 7-10-97 TAX MAP NO. 4733913026 Watershed: ☐ Yes ☑ No

OWNER OR CONTRACTOR ~~Rebecca Teaster~~ B.N. Black PHONE: Business Home 528 4704

ADDRESS 606 Old mtn Rd Statesville, N.C.

LOCATION 1155 To Cumberland To Bluebird To Skyuka 1/4 mi left

SUBDIVISION David Burrell property BLOCK / SECTION LOT 3 LOT AREA .77 acres SITE CLASS. PS DESIGN FLOW 360 L.T.A.R. .3

Septic Tank: 1000 Gallons; ST 1007 Date 11-21-97

Pump Tank: Gallons; PT Date

Pump Make: Model Serial No.

Nitrification Field: No Fields 1 Square Feet 1200 Linear Feet 400

No Lines 4 Trench Width 36" Max Trench Bottom Depth 36" Gravel Depth 7.11

☑ New System ☐ Repair System Type: I, II, III, IV, V, VI

System Description: conv. Gravity

Repair System Description: Gravity chambers

Maintenance Agreement Required: ☐ Yes ☑ No

☐ House/Mod. Home ☑ Mobile Home ☐ Business ☐ Other

No. Bedrooms 3 No. Bathrooms 2 No. Employees


☐ Slab ☑ Crawl Space ☐ Basement w/plumbing ☐ Basement wo/plumbing

Water Supply: ☑ Individual ☐ Community ☐ Public


Comments:

Comments: Same as initial sketch

INITIAL SITE SKETCH

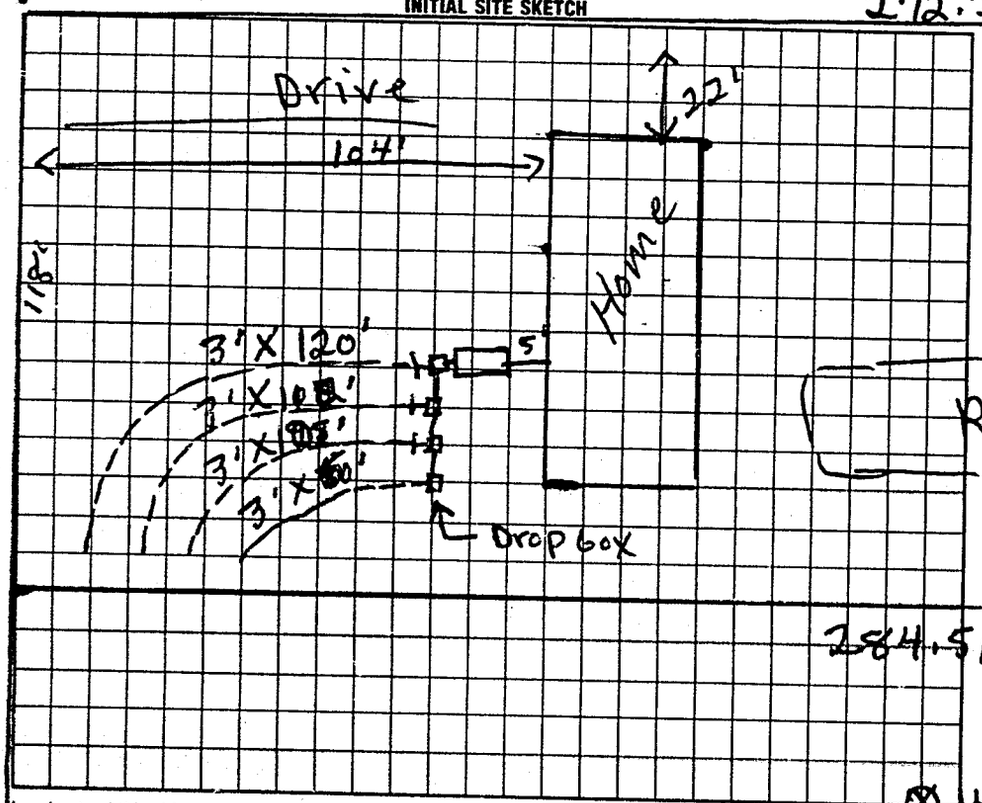

AS BUILT SKETCH

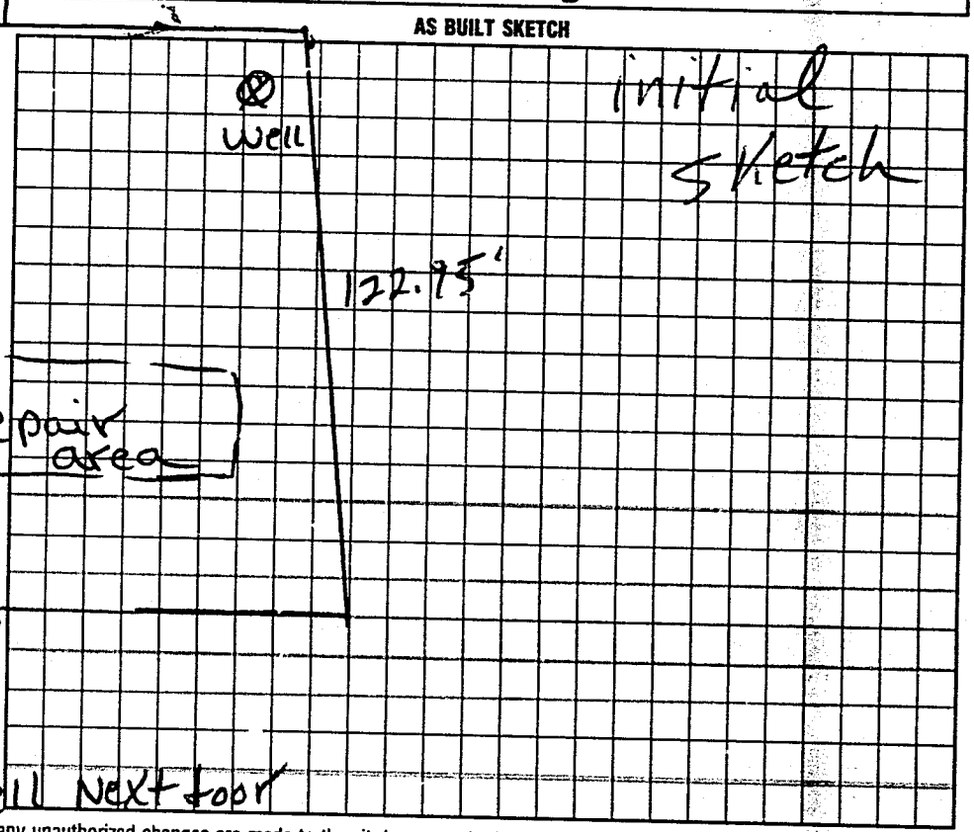

I understand that this permit can be suspended or revoked if any false information is supplied toward securing the permit/any unauthorized changes are made to the site/any unauthorized changes are made in the installation of the system. Improvement Permit is valid for 60 months from date of issuance.

Signed: ~~Rebecca Teaster~~

Improvement Permit by: P.C. Moore date 7-10-97

~~Authorization~~ Existing System Evaluation by P.C. Moore date 7-10-97

to count.

Installed by: James Hutley

Certificate of Completion by: date

Operation Permit by P.C. Moore date 1-21-98

Authorization to count. Expires 60 mos from issue.

HEALTH DEPT COPY: WHITE INSPECTION COPY (FINAL): GREEN OWNER COPY (FINAL): YELLOW INSPECTION COPY (INITIAL): PINK OWNER COPY (INITIAL): GOLD