C1

IREDELL COUNTY HEALTH DEPARTMENT

STATESVILLE 704-878-5305 MOORESVILLE 704-664-5281

IMPROVEMENT PERMIT / AUTHORIZATION TO CONSTRUCT / OPERATION PERMIT / EXISTING SYSTEM INSPECTION

PERMIT# 14776 PIN# 4733905037 704-873-2547 DATE 5-10-07

OWNER OR APPLICANT ~~REX KLETT~~ Clayton Homes PHONE: Business ~~704-450-6462~~ Home ~~704-876-2372~~

ADDRESS ~~193 DONSDALE DR STATESVILLE NC 28625~~ 2026 Northside Dr. [redacted] ~~980-722-5781~~

LOCATION 21 SOUTH (E) MOOSE CLUB (R) SKYUKA (R) ARLIE LOT ON LEFT

SUBDIVISION MEADOW PINES BLOCK / SECTION ____ LOT 3 LOT AREA .58 SITE CLASS. PS DESIGN FLOW 400 L.T.A.R. .5

Septic Tank: 1000 Gallons; STB ~~Sta-Rite~~ Date 1-21-07
Pump Tank: ____ Gallons; PT ____ Date ____
Pump Make: ____ Model ____ Serial No. ____
Nitrification Field: No Fields 1 Square Feet 60 = 1600' Linear Feet 400'
No Lines 5 Trench Width 36" Max Trench Bottom Depth 19"

☒ New System ☐ Repair ☐ Expansion System Type: I (II) III IV V VI
System Description: GRAVITY 25% REDUCT
Repair System Description: LP 50% REDUCT
Maintenance Agreement Required: ☐ Yes ☒ No
Gravel Depth N/A" ☒ Gravity ☐ Pressure

☐ House/Mod. Home No. Bedrooms 4
☒ Mobile Home D/W No. Persons 8
☐ Business No. Employees ____
☐ Other ____

Water Supply: ☒ Individual ☐ Public ☐ Community

☐ Slab ☒ Crawl Space ☐ Basement w/plumbing ☐ Basement wo/plumbing

Comments:/Conditions: (1) Note Maximum Trench Bottom Depth (2) Install Lines on Contour & Maintain Setbacks (3) System Flagged By R.S. House & P/L Flagged By Applicant.

NAT

Comments:/Conditions: Approved 76x27'4" HOUSE PLAN. Increase width of House from 66' WIDE, AS DRAWN, TO 76' LONG AS Applied. Keep Front of home in same location which will not affect the system.

INITIAL SITE SKETCH

SEE ATTACHED PERMIT

DESIGN BY LORNE COOK R.S.

AS BUILT SKETCH

FIH Installed.

Installed AS Drawn on Attached site plan

Permit can be suspended or revoked if any false information is supplied toward securing the permit/any unauthorized changes are made to the site/any unauthorized changes are made in the installation of the system. Improvement Permit with plat valid without expiration. ☐ Improvement Permit with site plan valid for sixty months ☒ Authorization to Construct is valid for a period equal to that of Improvement Permit – not to exceed sixty months.

Signed: Rex E Klett date ____

Improvement Permit by: Lorne Cook RS date 5-11-07

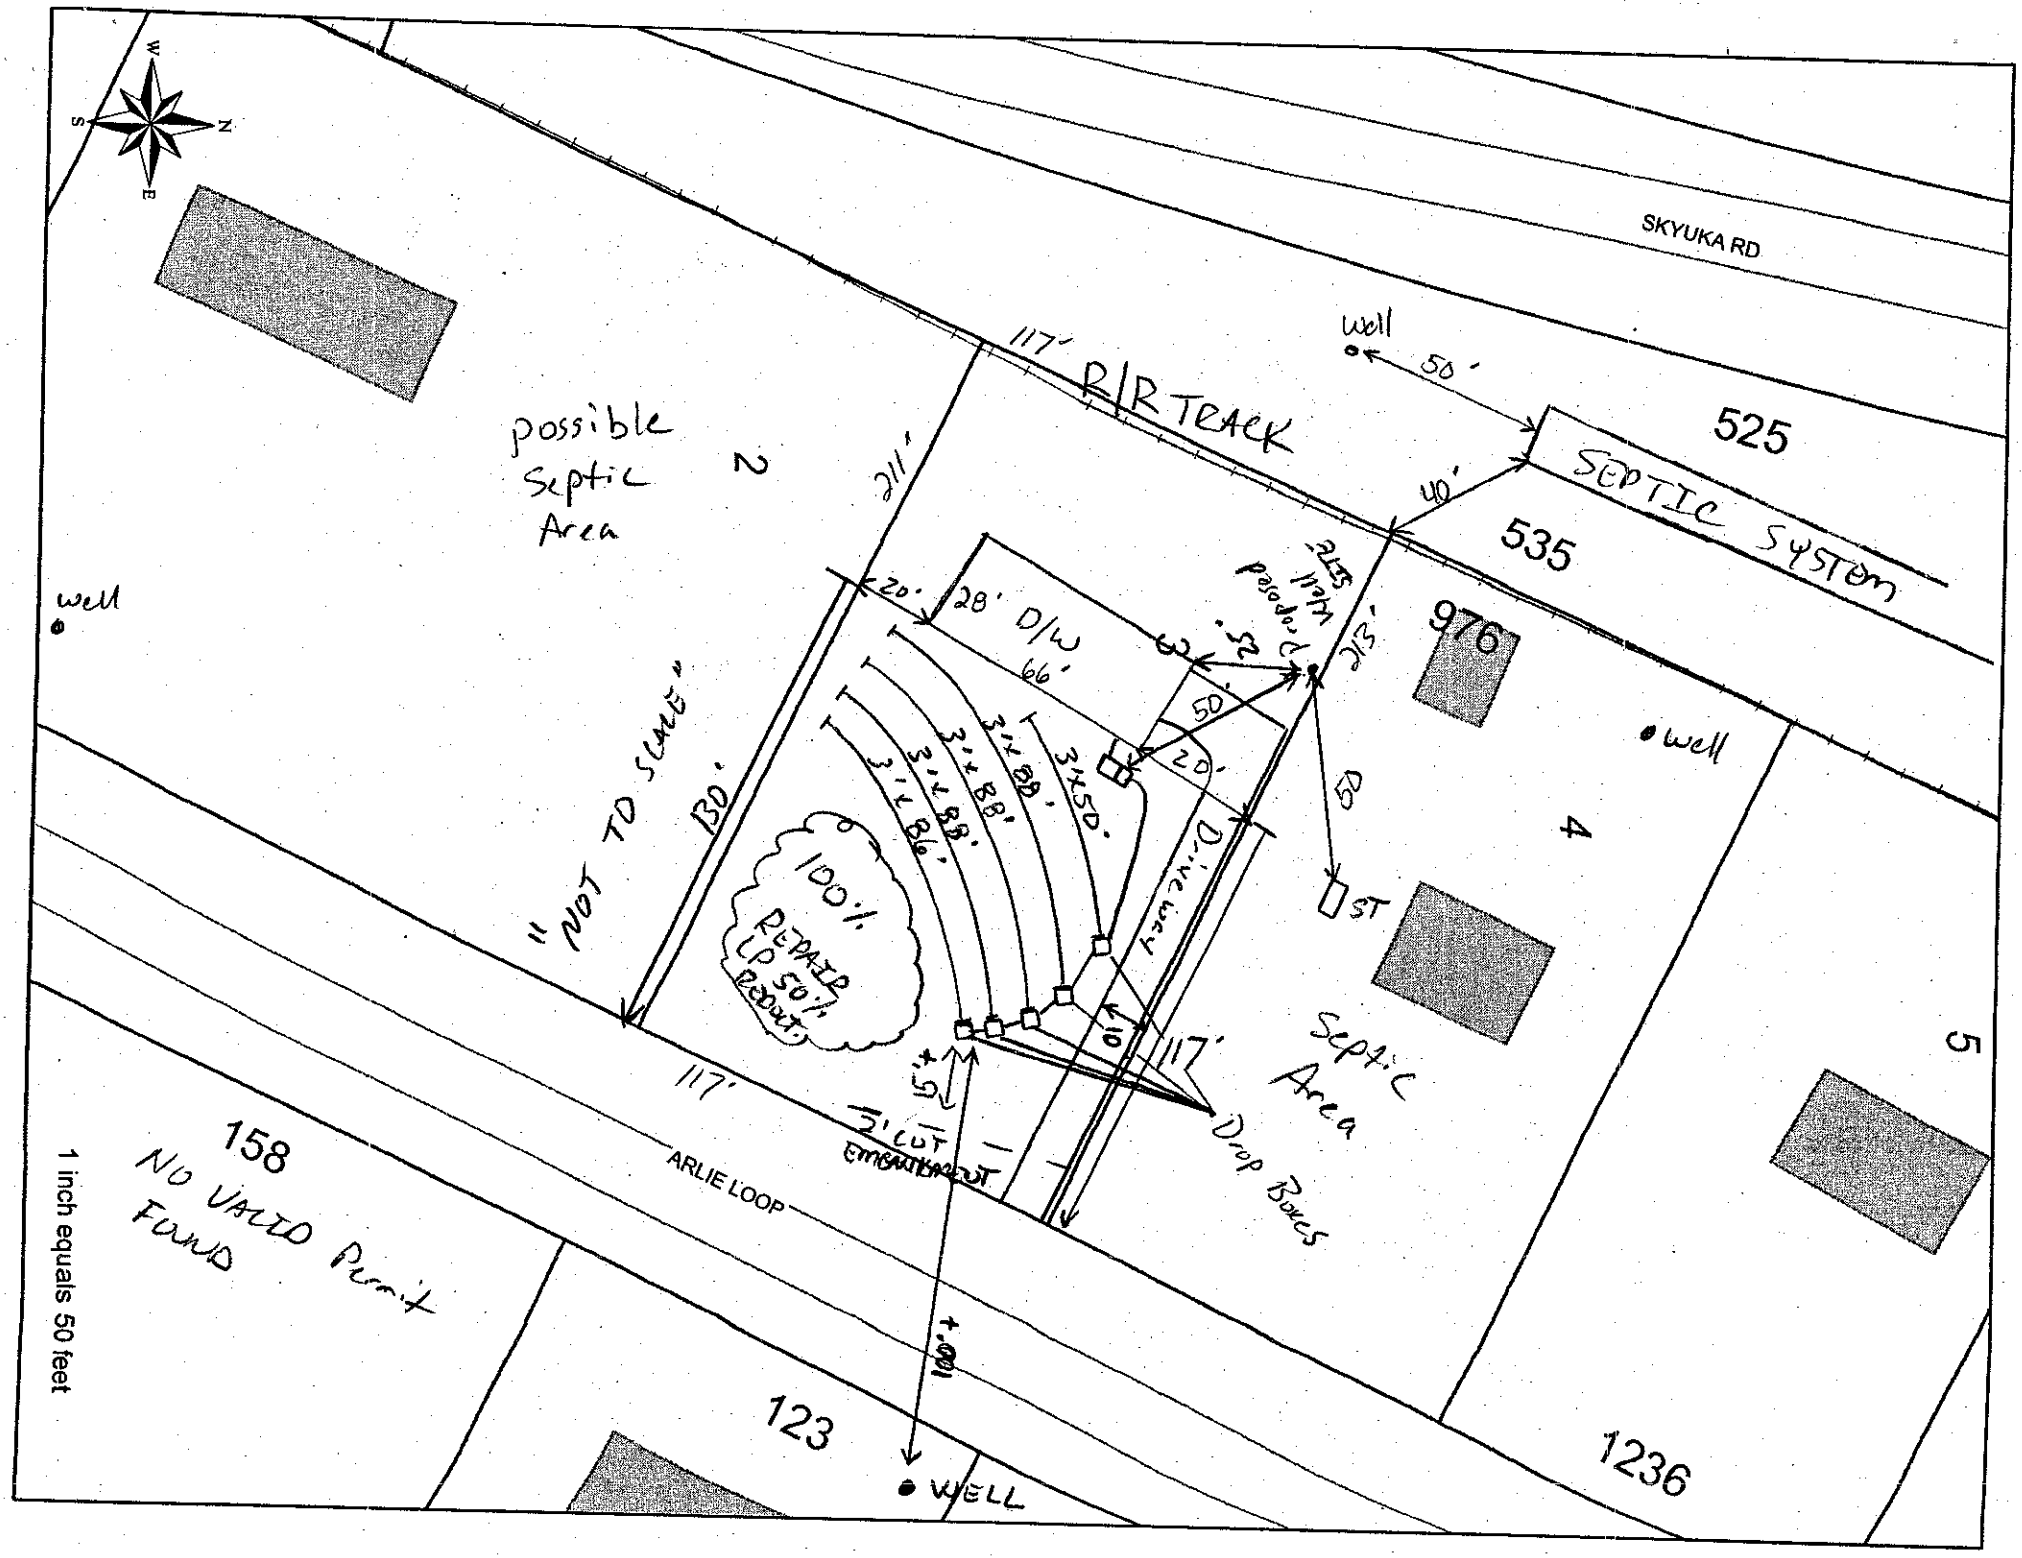
Authorization to Construct by: Lorne Cook RS date 5-16-07

Installed by: Tim Abee

Operation Permit by: Jim Duggan, R.S. date 24 May 07

Existing System Inspection by: ____ date ____

HEALTH DEPT. COPY: WHITE OWNER COPY (FINAL): YELLOW OWNER COPY (INITIAL): PINK


SKYUKA RD
117' R/R TRACK
well
50'
525
SEPTIC SYSTEM
535
976
40'
213'
211'
possible Septic Area 2
well
20'
28' D/W
66'
"NOT TO SCALE"
130'
50'
20'
50'
100% REPAIR UP 50% Reduct.
DRIVE WAY
ST
well
4
5
Septic Area
117'
+50'
3' CUT EMBANKMENT
Drop Boxes
10'
ARLIE LOOP
158
NO VALID Permit FOUND
123
+100'
WELL
1236
1 inch equals 50 feet