#153

IREDELL COUNTY HEALTH DEPARTMENT

STATESVILLE 704-878-5305 MOORESVILLE 704-664-5281

IMPROVEMENT PERMIT / AUTHORIZATION TO CONSTRUCT / OPERATION PERMIT / EXISTING SYSTEM INSPECTION

PERMIT# 089166 PIN# 4733-90-5023 PT DATE 11/16/01

OWNER OR CONTRACTOR STEVE HILKERT PHONE: Business Home

ADDRESS 146 CARRIAGE RD STATESVILLE 28677

LOCATION 215 - FL MOOSE CLUB - TL SKYUKA FR APPLE VALLEY - ON LT

SUBDIVISION MEADOW PINES BLOCK / SECTION LOT 4 LOT AREA — SITE CLASS PS DESIGN FLOW 360GPD L.T.A.R. 360 PD/KT

Septic Tank: 1000 Gallons: STB 1012 Date 05/03/02
Pump Tank: Gallons: PT Date
Pump Make: Model Serial No
Nitrification Field: No Fields 1 Square Feet 900 Linear Feet 300
No Lines 4@75' Trench Width 36" Max Trench Bottom Depth 36"

☑ New System ☐ Repair System Type: I. II (III) IV. V. VI
System Description: GRAVITY 25% REDUCTION
Repair System Description: PANEL
Maintenance Agreement Required: ☐ Yes ☑ No
Gravel Depth N/A ☐ Slab ☑ Crawl Space ☐ Basement w/plumbing ☐ Basement wo/plumbing


☑ House/Mod. Home No. Bedrooms 3
☑ Mobile Home No. Bathrooms 3
☐ Business No. Employees
☐ Other

Water Supply: ☑ Individual ☐ Public ☐ Community

Comments:/Conditions:


Comments:/Conditions:
House plan OK'd 7/25/02 for 2 Br Home
* SYSTEM INSTALLED AS SHOWN BELOW IN "AS BUILT SKETCH"

INITIAL SITE SKETCH 1"=50'

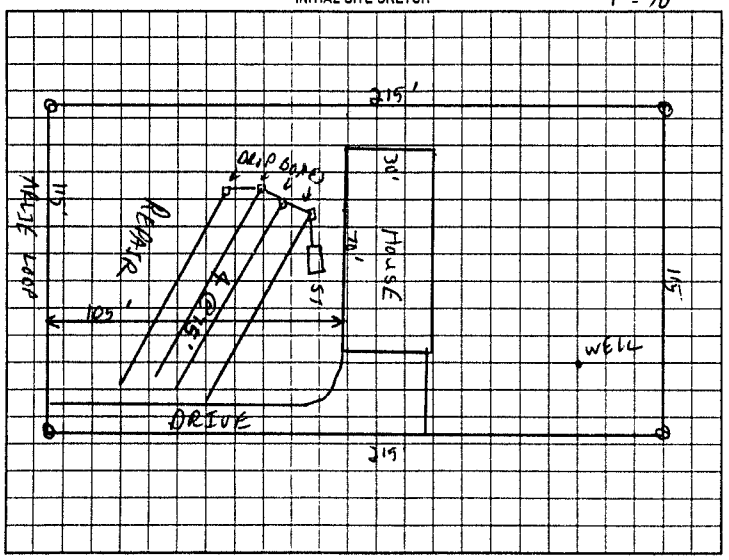

AS BUILT SKETCH

* ONLY CHANGE WAS TANK LOCATION
- SEPTIC TANK INSTALLED USING POLYFLOC FILTER & MARKER

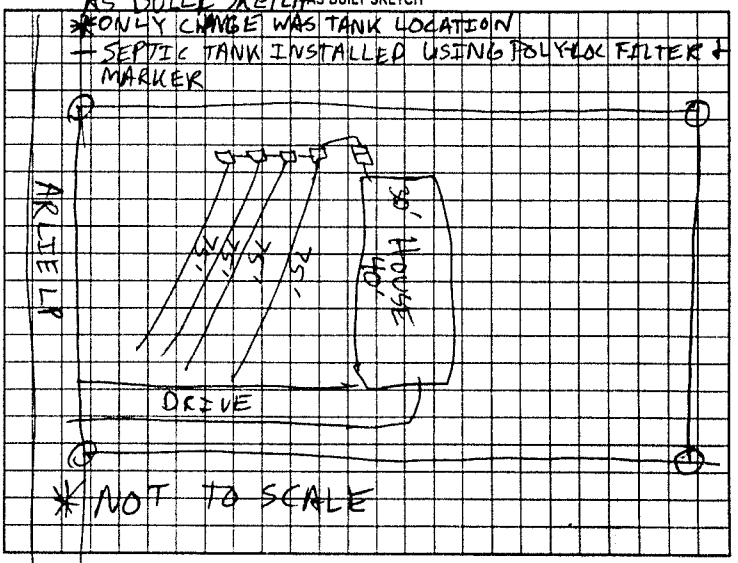

Permit can be suspended or revoked if any false information is supplied toward securing the permit/any unauthorized changes are made to the site/any unauthorized changes are made in the installation of the system. Improvement Permit with plat valid ~~without expiration~~. Improvement Permit w/o site plan valid for sixty months. Authorization to Construct is valid for a period equal to that of Improvement Permit – not to exceed sixty months.

Signed: date 7-17-02 Installed by: CRAG THOMPSON GRADING

Improvement Permit by: C. date 11/16/01 Operation Permit by: Patrick Mitchell date 08/16/02

Authorization to Construct by: -Kelly Shocks date 7/25/02 Existing System Inspection by: date

HEALTH DEPT. COPY WHITE OWNER COPY (FINAL) YELLOW OWNER COPY (INITIAL) PINK