IREDELL COUNTY HEALTH DEPARTMENT

STATESVILLE 704-878-5305 (c) MOORESVILLE 704-664-5281

IMPROVEMENT PERMIT / AUTHORIZATION TO CONSTRUCT / OPERATION PERMIT / EXISTING SYSTEM INSPECTION

PERMIT# 116073 PIN# 4733-91-4106 DATE 10-14-03

OWNER OR CONTRACTOR OLLIS J. BURRELL PHONE: Business _____ Home 704-528-5713

ADDRESS 331 MORRISON FARM ROAD, TROUTMAN, NC 28166

LOCATION US 21 SOUTH, TL CUMBERLAND AVENUE, TL SCROGGS CEMETARY ROAD, LOT ON RIGHT AT END

SUBDIVISION _____ BLOCK / SECTION _____ LOT _____ LOT AREA 1.576 ACRES SITE CLASS. PS DESIGN FLOW 360 L.T.A.R. 0.30 GPD/FT²

Septic Tank: 1000 Gallons; STB 825 Date 10-20-03
Pump Tank: _____ Gallons; PT _____ Date _____
Pump Make: _____ Model _____ Serial No. _____
Nitrification Field: No Fields 1 Square Feet 1200 Linear Feet 400
No Lines THREE Trench Width 36 Max Trench Bottom Depth 36 Gravel Depth 12"

☑ New System ☐ Repair System Type: I, II, III, IV, V, VI
System Description: CONVENTIONAL GRAVITY
Repair System Description: 50% REDUCTION, LOW PRESSURE
Maintenance Agreement Required: ☐ Yes ☑ No

☐ House/Mod. Home ☑ Mobile Home ☐ Business ☐ Other
No. Bedrooms 3 No. Bathrooms 2 No. Employees _____


☐ Slab ☑ Crawl Space ☐ Basement w/plumbing ☐ Basement wo/plumbing

Water Supply: ☑ Individual ☐ Public ☐ Community
WELL

Comments:/Conditions: ① INSTALL SUBSURFACE INTERCEPT DRAINAGE DITCH AT LOCATION SHOWN BEGINNING 48" DEEP AT UPHILL SYSTEM, THEN OUT TO DAYLIGHT ② KEEP SYSTEM MINIMUM 100' FROM WELL

Comments:/Conditions: ① SEPTIC TANK WITH MARKER INSTALLED USING "POLYLOK" FILTER ② SYSTEM INSTALLED DEEPER THAN NECESSARY

INITIAL SITE SKETCH

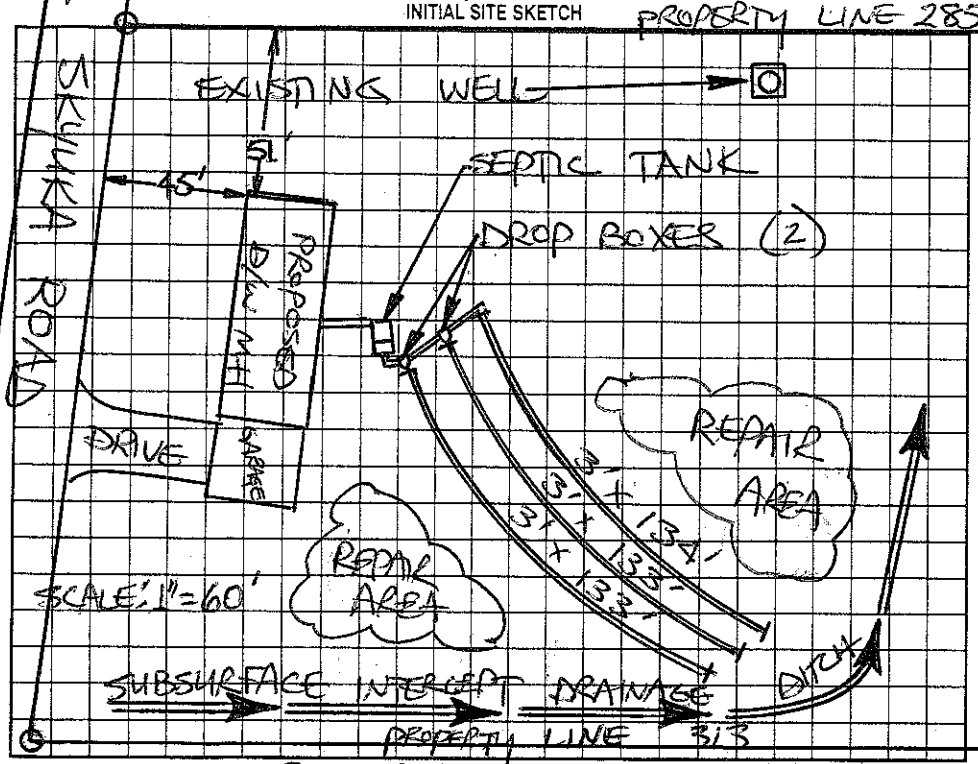

AS BUILT SKETCH

SYSTEM INSTALLED ACCORDING TO INITIAL SITE SKETCH

Permit can be suspended or revoked if any false information is supplied toward securing the permit, any unauthorized changes are made to the site/any unauthorized changes are made in the installation of the system. Improvement Permit with plat valid without expiration. Improvement Permit with site plan valid for sixty months. Authorization to Construct is valid for a period equal to that of Improvement Permit – not to exceed sixty months.

Signed: † Ollis J Burrell date 10-14-03 Installed by: BOB'S BACKHOE

Improvement Permit by: STEVE HEDRICK date 10-14-03 Operation Permit by: STEVE HEDRICK date 1-7-04

Authorization to Construct by: STEVE HEDRICK date 10-14-03 Existing System Inspection by: _____ date _____

HEALTH DEPT. COPY: WHITE OWNER COPY (FINAL): YELLOW OWNER COPY (INITIAL): PINK