IREDELL COUNTY HEALTH DEPARTMENT

STATESVILLE 704-878-5305 MOORESVILLE 704-664-5281

IMPROVEMENT PERMIT / AUTHORIZATION TO CONSTRUCT / OPERATION PERMIT / EXISTING SYSTEM INSPECTION

PERMIT# 151977 PIN# 4733918308 DATE 9-2-08

OWNER OR APPLICANT Tina K. Osborne PHONE: Business 704-657-6253 Home

ADDRESS 163 Keaton RD Cleveland NC 27013

LOCATION 215 → Shelton Ave (R) Cumberland (R) Bluebird (R) Skyuka across from SCR066 Com.

SUBDIVISION BLOCK / SECTION LOT LOT AREA 1.092 SITE CLASS. 23 DESIGN FLOW 360 L.T.A.R. 13

Septic Tank: 1000 Gallons; STB 160 Date 10-31-08

Pump Tank: Gallons; PT Date

Pump Make: Model Serial No.

Nitrification Field: No Fields Square Feet 1200 Linear Feet 300

No Lines 4 Trench Width 36" Max Trench Bottom Depth 36"

☑ New System ☐ Repair ☐ Expansion System Type: I II III IV V VI

System Description: 2500 Gravity

Repair System Description: 5070 Low Pres

Maintenance Agreement Required: ☐ Yes ☐ No

Gravel Depth ☑ Gravity ☐ Pressure

☐ House/Mod. Home ☑ Mobile Home ☐ Business ☐ Other

No. Bedrooms 3 No. Persons No. Employees

Water Supply: ☑ Individual ☐ Public ☐ Community

☐ Slab ☑ Crawl Space ☐ Basement w/plumbing ☐ Basement wo/plumbing


Comments:/Conditions:

Comments:/Conditions: POLYLOK F.H.A. MANUAL


Install per Options

Maintain all Setbacks

INITIAL SITE SKETCH

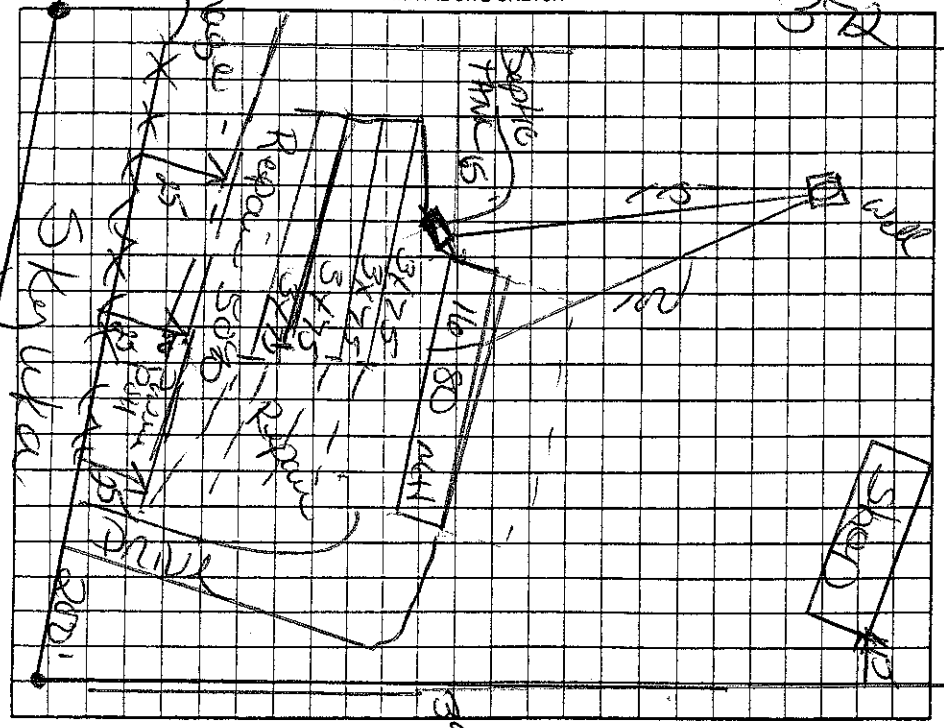

AS BUILT SKETCH

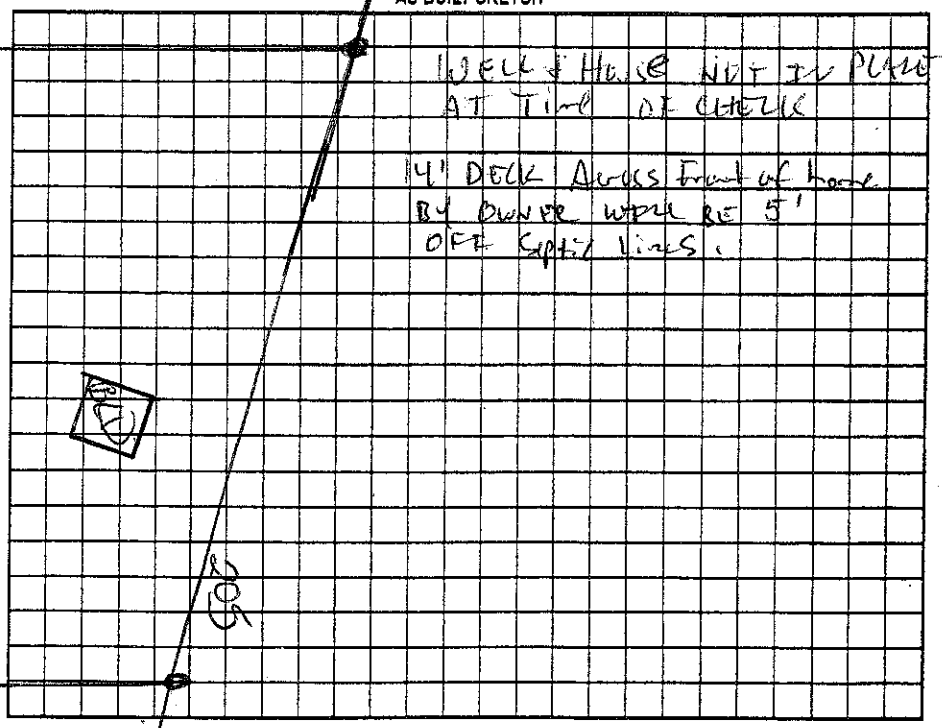

Permit can be suspended or revoked if any false information is supplied toward securing the permit/any unauthorized changes are made to the site/any unauthorized changes are made in the installation of the system. Improvement Permit with plat valid without expiration ☐ Improvement Permit with site plan valid for sixty months ☑ Authorization to Construct is valid for a period equal to that of Improvement Permit – not to exceed sixty months.

Signed: [signature] date 9-2-08 Installed by: Hoffmann Septic Tank Service INC

Improvement Permit by: [signature] date 9-2-08 Operation Permit by: [signature] date 2-6-09

Authorization to Construct by: [signature] date 9-2-08 Existing System Inspection by: date

HEALTH DEPT. COPY: WHITE OWNER COPY (FINAL): YELLOW OWNER COPY (INITIAL): PINK