(400 - 430)

IREDELL COUNTY HEALTH DEPARTMENT

STATESVILLE 704-878-5305 MOORESVILLE 704-664-5281

IMPROVEMENT PERMIT / AUTHORIZATION TO CONSTRUCT / OPERATION PERMIT / EXISTING SYSTEM INSPECTION

PERMIT# 91737 PIN# 4733918554

OWNER OR CONTRACTOR Doris Call DATE 8-16-00

ADDRESS 336 Skyuka Rd Statesville N.C. PHONE: Business ______ Home 873 9035

LOCATION 21 S TL Cumberland TL Bluebird TL Skyuka 1/2 mi on rt

SUBDIVISION ______ BLOCK / SECTION ______ LOT ______ LOT AREA 2.2 acres SITE CLASS PS DESIGN FLOW 360 L.T.A.R. .3

Septic Tank: 1000 Gallons; STB 10/2 Date 7/10/00

Pump Tank: ______ Gallons; PT ______ Date ______

Pump Make: ______ Model ______ Serial No. ______

Nitrification Field: No Fields 1 Square Feet 1200 Linear Feet 400

No Lines 5 Trench Width 36" Max Trench Bottom Depth 36" Gravel Depth 12"

☑ New System ☐ Repair System Type: I (II) III, IV, V, VI

System Description: Conv. Gravity

Repair System Description: " "

Maintenance Agreement Required: ☐ Yes ☑ No

☐ Slab ☑ Crawl Space ☐ Basement w/plumbing ☐ Basement wo/plumbing

☐ House/Mod. Home ☑ Mobile Home ☐ Business ☐ Other ______


No. Bedrooms 3 No. Bathrooms 2 No. Employees ______

Water Supply: ☑ Individual ☐ Public ☐ Community


Comments/Conditions:

Comments/Conditions:

INITIAL SITE SKETCH

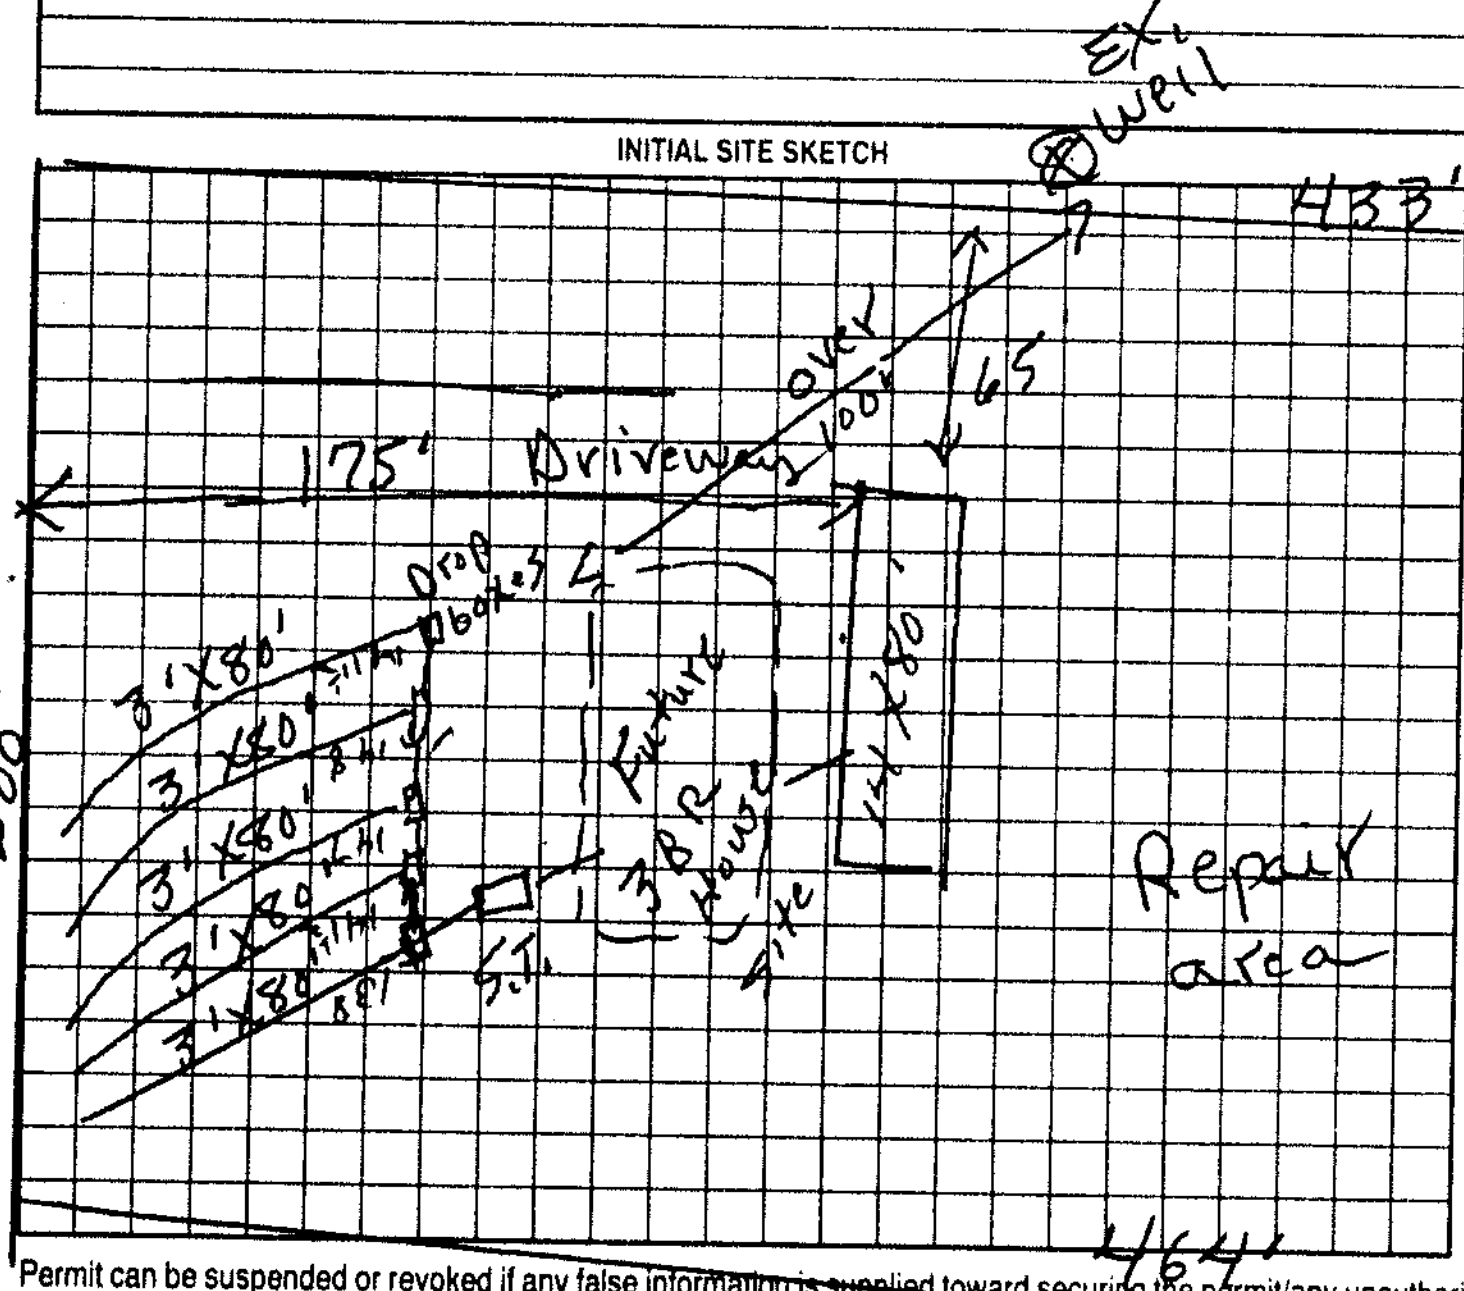

AS BUILT SKETCH

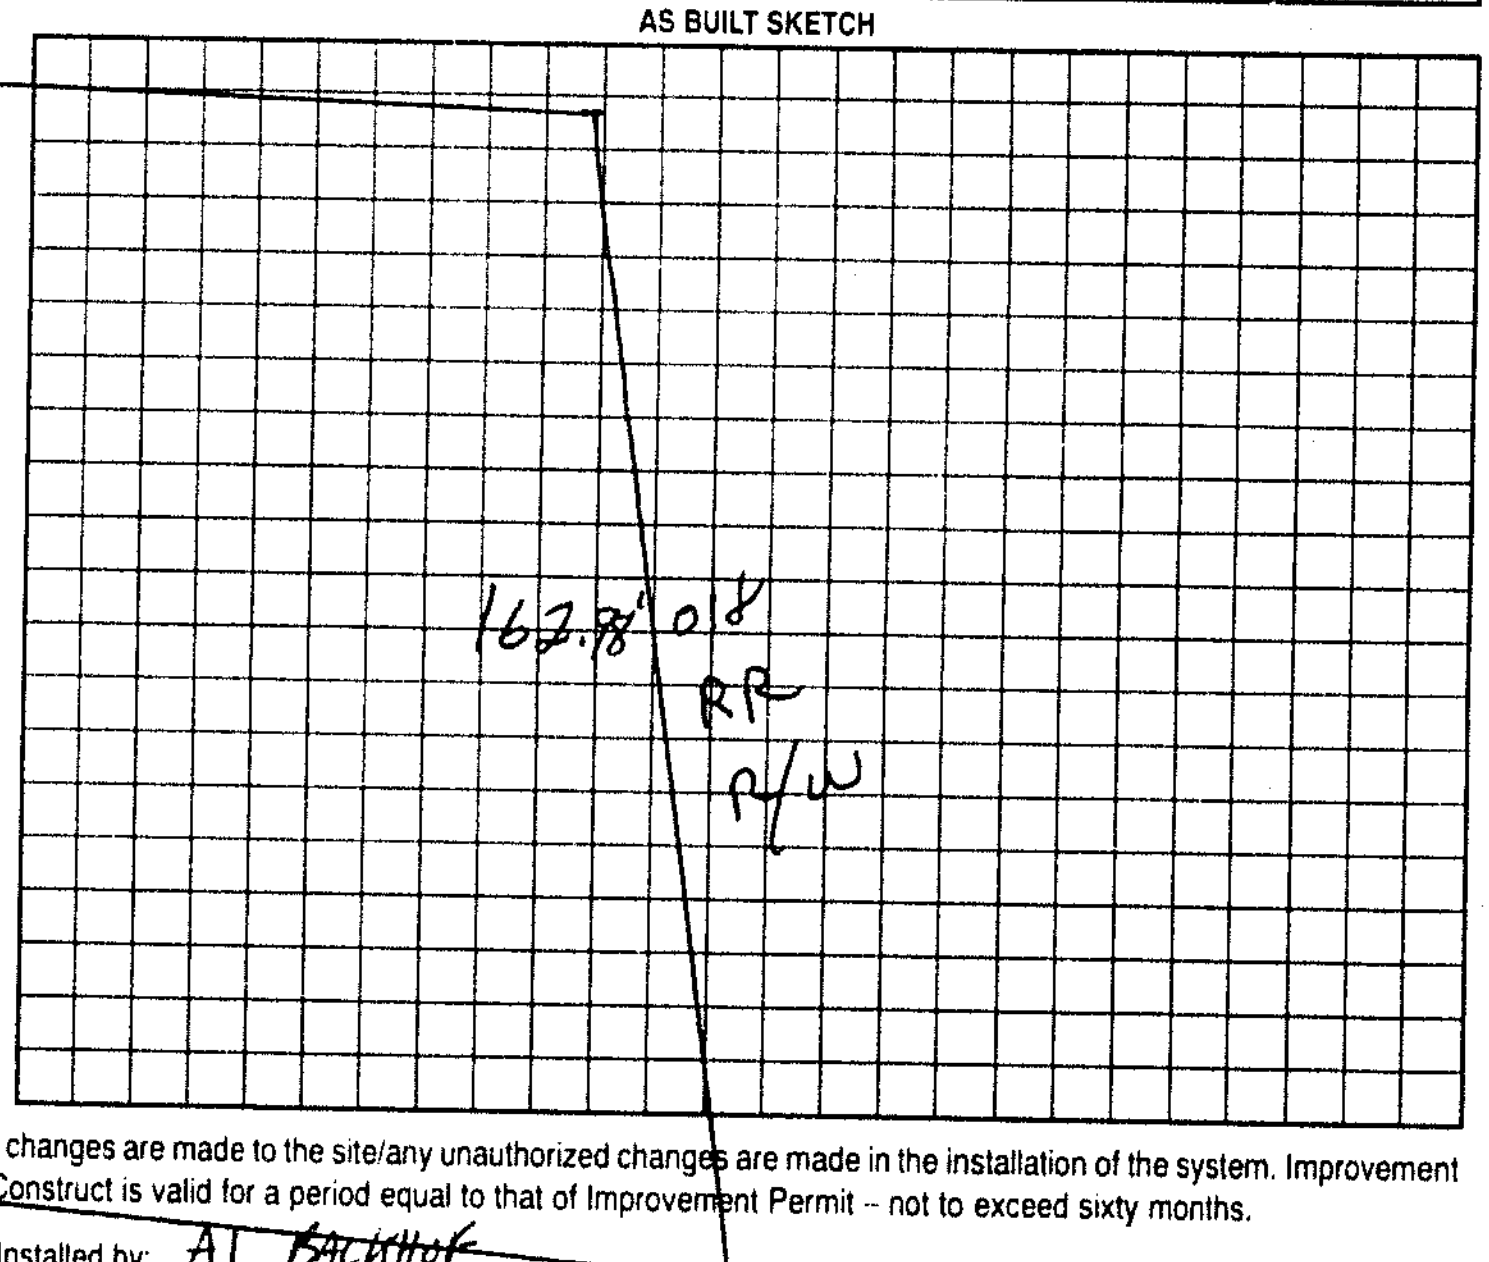

Permit can be suspended or revoked if any false information is supplied toward securing the permit/any unauthorized changes are made to the site/any unauthorized changes are made in the installation of the system. Improvement Permit with plat valid without expiration. Improvement Permit with site plan valid for sixty months. Authorization to Construct is valid for a period equal to that of Improvement Permit -- not to exceed sixty months.

Signed: X Doris W. Call date ______ Installed by: A1 Backhoe

Improvement Permit by: L. C. Moore date 8-16-00 Operation Permit by: C. [illegible] RS date 8/24/00

Authorization to Construct by: L. C. Moore date 8-16-00 Existing System Inspection by: ______ date ______

HEALTH DEPT COPY WHITE OWNER COPY (FINAL) YELLOW OWNER COPY (INITIAL) PINK