2-30

THIS PERMIT REPLACES PREVIOUS ISSUED 8-27-05 #

IREDELL COUNTY HEALTH DEPARTMENT

STATESVILLE 704-878-5305 MOORESVILLE 704-664-5281

IMPROVEMENT PERMIT / AUTHORIZATION TO CONSTRUCT / OPERATION PERMIT / EXISTING SYSTEM INSPECTION

PERMIT# 130854 PIN# 4733-91-8788 DATE 7-30-07

OWNER OR APPLICANT DUSTIN HOWELL PHONE: Business 704-978-5437 Home 704-437-0302

ADDRESS 328 SKYUKA ROAD STATESVILLE NC 28677

LOCATION US 21 SOUTH, TL MOOSE CLUB ROAD, TL SKYUKA ROAD, HOUSE ON RIGHT AT # 328

SUBDIVISION _____ BLOCK / SECTION _____ LOT _____ LOT AREA 2.174 ACRES SITE CLASS. PS1 DESIGN FLOW 480 L.T.A.R. 480 GPD/FT²

Septic Tank: EXISTING Gallons; STB _____ Date _____

Pump Tank: _____ Gallons; PT _____ Date _____

Pump Make: _____ Model _____ Serial No. _____

Nitrification Field: No Fields 1 Square Feet EQ TO 400 Linear Feet 100

No Lines TWO Trench Width 36" Max Trench Bottom Depth 36"

☐ New System ☐ Repair ☑ Expansion System Type: I II III IV V VI

System Description: 25% REDUCTION GRAVITY

Repair System Description: 25% REDUCTION, PUMP

Maintenance Agreement Required: ☐ Yes ☑ No

Gravel Depth N/A ☑ Gravity ☐ Pressure

☑ House/Mod. Home ☐ Mobile Home ☐ Business ☐ Other

No. Bedrooms 4 No. Persons ____ No. Employees ____


Water Supply: ☑ Individual ☐ Public ☐ Community WELL

☐ Slab ☑ Crawl Space ☐ Basement w/plumbing ☐ Basement wo/plumbing


Comments:/Conditions: ① INSTALL NEW DROP BOX AT LOCATION SHOWN ② INSTALL NEW 25% REDUCTION SYSTEM ON CONTOUR AS FLAGGED ON SITE.

Comments:/Conditions:

INITIAL SITE SKETCH

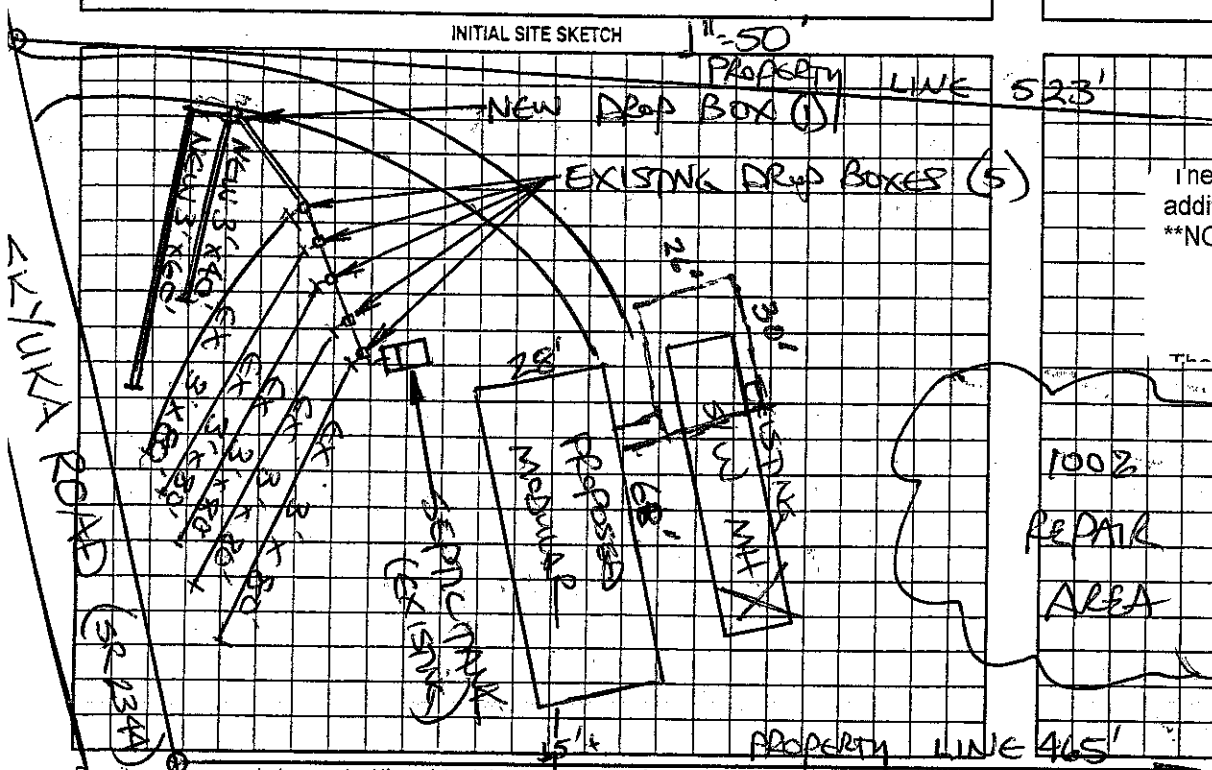

AS BUILT SKETCH

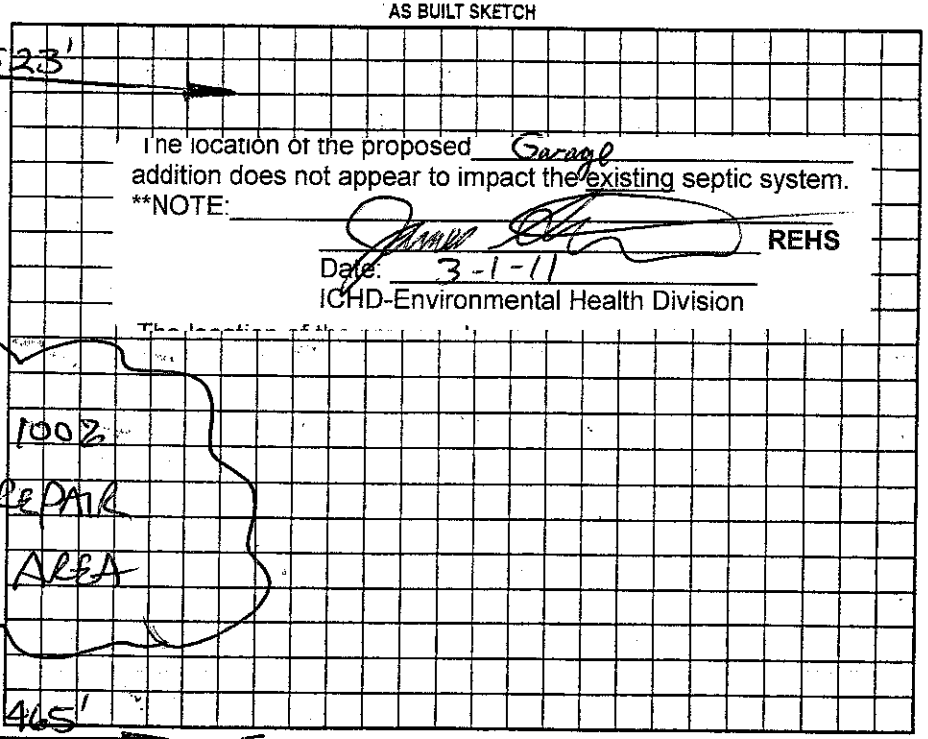

The location of the proposed Garage addition does not appear to impact the existing septic system.

**NOTE:

REHS

Date: 3-1-11

ICHD-Environmental Health Division

Permit can be suspended or revoked if any false information is supplied toward securing the permit/any unauthorized changes are made to the site/any unauthorized changes are made in the installation of the system. Improvement Permit with plat valid without expiration ☐ Improvement Permit with site plan valid for sixty months ☑ Authorization to Construct is valid for a period equal to that of Improvement Permit – not to exceed sixty months.

Signed: Dustin B. Howell date 7-30-07

Improvement Permit by: STEVE HEDRICK date 7-30-07

Authorization to Construct by: STEVE HEDRICK date 7-30-07

Installed by: A-1 Backhoe

Operation Permit by: _____ date 10-10-07

Existing System Inspection by: _____ date _____

HEALTH DEPT. COPY: WHITE OWNER COPY (FINAL): YELLOW OWNER COPY (INITIAL): PINK