IREDELL COUNTY HEALTH DEPARTMENT

STATESVILLE 704-878-5305 MOORESVILLE 704-664-5281

IMPROVEMENT PERMIT / AUTHORIZATION TO CONSTRUCT / OPERATION PERMIT / EXISTING SYSTEM INSPECTION

PERMIT# Repair PIN# DATE 3-18-99

OWNER OR CONTRACTOR Mike Kilpatrick PHONE: Business Home

ADDRESS 841 Knox Ave Statesville

LOCATION 70W TL Park Drive TR Bristol TL Knox Ave house on R

SUBDIVISION BLOCK / SECTION LOT LOT AREA SITE CLASS. P/3 DESIGN FLOW 360 gpd L.T.A.R. 0.3

Septic Tank: 1000 Existing Gallons; STB [redacted] Date [redacted]

Pump Tank: 1000 Gallons; PT 188 Date 1-25-94

Pump Make: Model Serial No.

Nitrification Field: No Fields Square Feet Linear Feet 300

No Lines 5 Trench Width 36 Max Trench Bottom Depth 36

☐ New System ☒ Repair System Type: I. II. III. IV. V. VI

System Description:

Repair System Description: Pump to 25% reduction

Maintenance Agreement Required: ☐ Yes ☒ No

~~Gravel Depth~~ Sand ☐ Slab ☒ Crawl Space ☐ Basement w/plumbing ☐ Basement wo/plumbing

☒ House/Mod. Home No. Bedrooms 3

☐ Mobile Home No. Bathrooms 2

☐ Business No. Employees


☐ Other

Water Supply: ☐ Individual ☒ Public ☐ Community

Comments/Conditions: See attached sheets
Need to install pump tank, pressure manifold

Comments/Conditions:
4/14 checked tank, D boxlines, set pressure
Need elec box, alarm

INITIAL SITE SKETCH

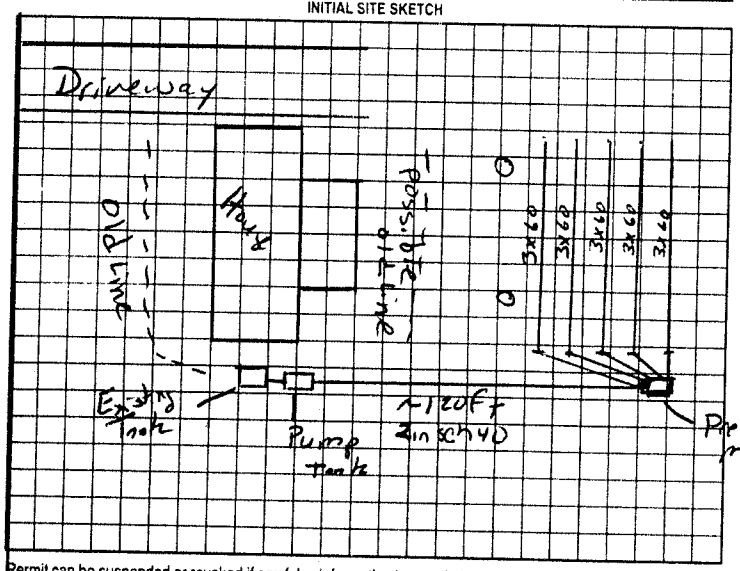

AS BUILT SKETCH

Permit can be suspended or revoked if any false information is supplied toward securing the permit/any unauthorized changes are made to the site/any unauthorized changes are made in the installation of the system. Improvement Permit with plat valid without expiration. Improvement Permit with site plan valid for sixty months. Authorization to Construct is valid for a period equal to that of Improvement Permit – not to exceed sixty months.

Signed: Steve Oxman RS date 3-19-99

Improvement Permit by: Mark Cox RS date 3-18-99

Authorization to Construct by: Mark Cox RS date 3-18-99

Installed by: Berry Syman

Operation Permit by: Mark Cox RS date 4-22-99

Existing System Inspection by: date

HEALTH DEPT. COPY: WHITE OWNER COPY (FINAL) YELLOW OWNER COPY (INITIAL) PINK