IREDELL COUNTY HEALTH DEPARTMENT

Statesville Phone TR 3-7271 Mooresville Phone No. 664-5281

PERMIT TO INSTALL SEPTIC TANK

Permit No. 49 Permit Date 11-3 19 77

Owner Sherrill Lumber Co Address Statesville

Installed By Henry Sigmon Address Statesville N C


Location of Property 2001 Bristol Rd

Tank		Capacity		Length of Lines		Fixtures	
Block	( )	1000	( )	225'	(✓)	No. of Baths	( )
Precast	( )	1250	( )	250'	( )	Dishwasher	( )
		1500	( )	Other		Garbage Grdr.	( )
		Other				Other	

NOTIFY HEALTH DEPARTMENT AT LEAST EIGHT HOURS BEFORE TANK IS TO BE INSPECTED.

Final Inspection 11-3 1977 Approved (✓) Disapprcved ( )

Remarks City Water

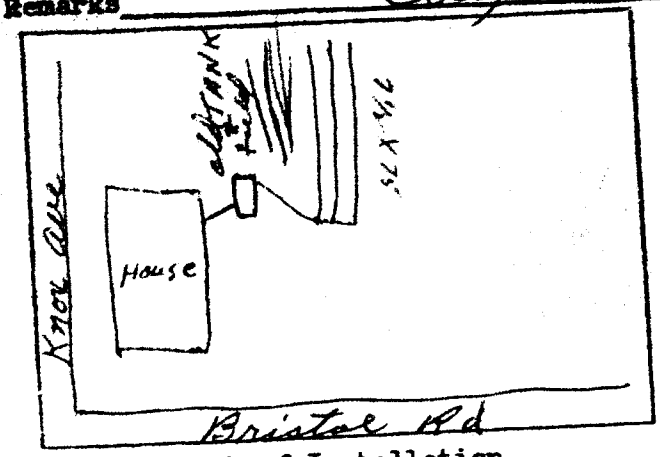

Sketch of Installation

Repair - Put in new drainfield

E. G. Stevenson

Sanitarian