IREDELL COUNTY HEALTH DEPARTMENT

STATESVILLE 704-878-5305 MOORESVILLE 704-664-5281

IMPROVEMENT PERMIT / AUTHORIZATION TO CONSTRUCT / OPERATION PERMIT / EXISTING SYSTEM INSPECTION

PERMIT# REPAIR PIN# 4734-03-4648 DATE 9-6-05

OWNER OR CONTRACTOR KOUA VANG PHONE: Business 704-433-8308 Home 704-636-8531

ADDRESS 1419 N. MAIN ST., SALISBURY, NC 28144

LOCATION US 70 WEST, TL BRISTOL ROAD, 2ND HOUSE ON RIGHT PAST KNOX STREET

SUBDIVISION BANK HEIGHTS BLOCK / SECTION ____ LOT 3 LOT AREA 0.46 ACRE SITE CLASS PS DESIGN FLOW 240 L.T.A.R. EXISTING 0.3 CONFIG

Septic Tank: EXISTING Gallons: STB ____ Date ____

Pump Tank: ____ Gallons: PT ____ Date ____

Pump Make: ____ Model ____ Serial No. ____

Nitrification Field: No Fields 1 Square Feet 540 Linear Feet 180

No Lines TWO Trench Width 36" Max Trench Bottom Depth 36

☐ New System ☑ Repair System Type: I, II, III, IV, V, VI

System Description: ____

Repair System Description: CONVENTIONAL GRAVITY

Maintenance Agreement Required: ☐ Yes ☑ No

Gravel Depth 18"

☑ House/Mod. Home No. Bedrooms 2

☐ Mobile Home No. Bathrooms ____

☐ Business No. Employees ____

☐ Other ____


☐ Slab ☑ Crawl Space ☐ Basement w/plumbing ☐ Basement wo/plumbing

Water Supply: ☐ Individual ☑ Public ☐ Community


Comments:/Conditions: INSTALL NEW SANITARY TEE IN SEPTIC TANK. INSTALL NEW DISTRIBUTION BOX FEEDING EXISTING LINE AS WELL AS TWO NEW LINES. MAY USE 18" STONE OR 25% REDUCTION SYSTEM (SAME LENGTH)

Comments:/Conditions: THIS PERMIT SERVES AS NOTICE of VIOLATION SYSTEM TO BE REPAIRED BY OCT 6, 05

INITIAL SITE SKETCH

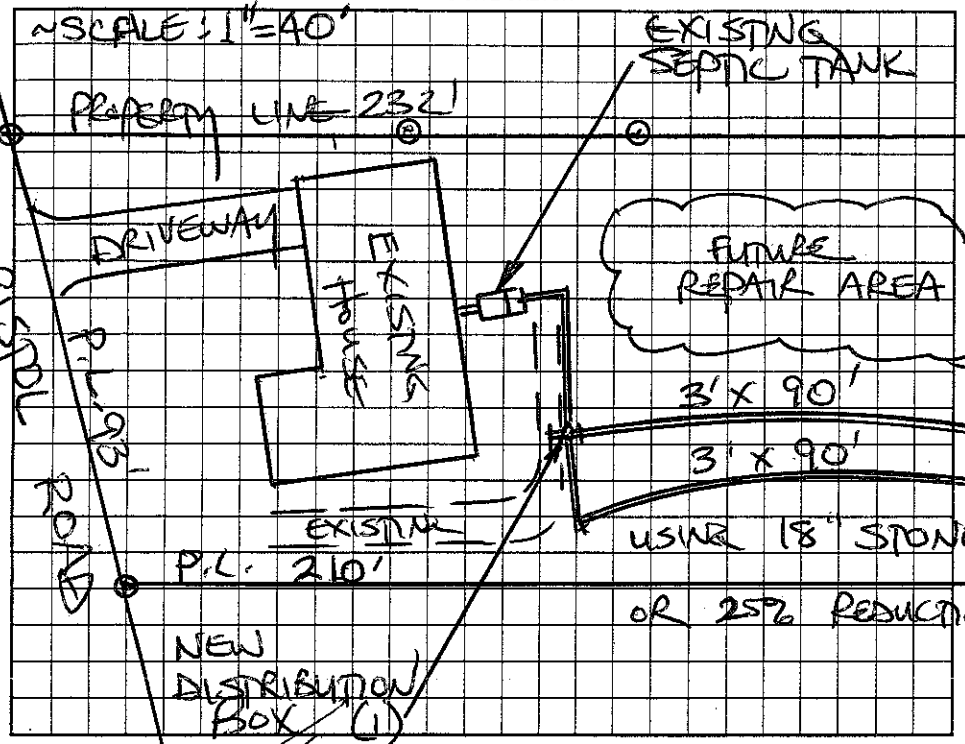

AS BUILT SKETCH

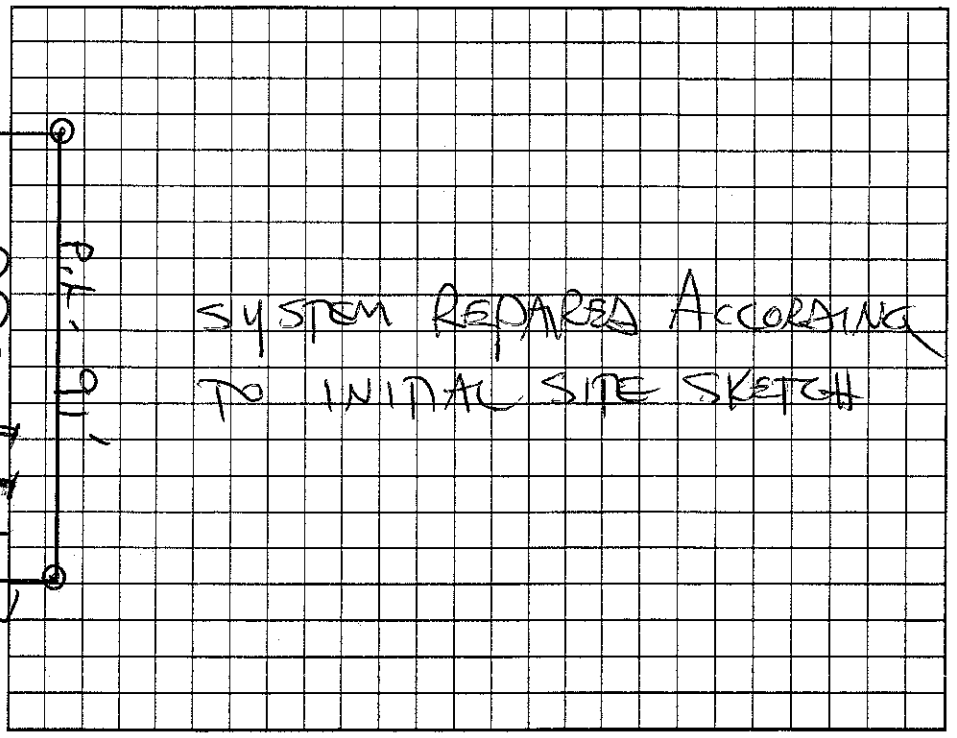

Permit can be suspended or revoked if any false information is supplied toward securing the permit/any unauthorized changes are made to the site/any unauthorized changes are made in the installation of the system. Improvement Permit with plat valid without expiration. Improvement Permit with site plan valid for sixty months. Authorization to Construct is valid for a period equal to that of Improvement Permit – not to exceed sixty months.

Signed: ____ date 9-6-05 Installed by: ROWAN SEPTIC

Improvement Permit by: STEVE HEDRICK date 9-6-05 Operation Permit by: STEVE HEDRICK date 9-21-05

Authorization to Construct by: STEVE HEDRICK date 9-6-05 Existing System Inspection by: ____ date ____

HEALTH DEPT. COPY: WHITE OWNER COPY (FINAL): YELLOW OWNER COPY (INITIAL): PINK