IREDELL COUNTY HEALTH DEPARTMENT - *ENVIRONMENTAL HEALTH* ☑ STATESVILLE OFFICE 704-878-5305 ☐ MOORESVILLE OFFICE 704-664-5281

IMPROVEMENT PERMIT / AUTHORIZATION TO CONSTRUCT / OPERATION PERMIT / EXISTING SYSTEM INSPECTION

PERMIT # REPAIR PIN # 4734-04-1661 DATE NOVEMBER 23, 2010

OWNER JOE WAYNE DILLARD PHONE: Home/Cell # 704-546-2089 Business #

SITE ADDRESS 2028 GAGNER STREET OWNER / APPLICANT ADDRESS 574 SHEFFIELD ROAD, HARMONY

SITE DIRECTIONS US 70 W, TL GRIER ST, TL GAGNER ST, 3RD LOT ON LEFT

SUBDIVISION RAYON PARK BLOCK / SECTION LOT # 48 LOT AREA 0.34 AC DESIGN FLOW 240 L.T.A.R. EX.

Septic Tank 1000 Gallons: STB 760 Date 6-21-10 ☐ New System ☑ Repair ☐ Expansion System Type I (II) III IV V VI ☑ Residence No. Bedrooms 2 Water Supply

Pump Tank Gallons: P T Date ☐ Business No. Persons ☑ Private

Pump Make Model Serial # System Description: ☑ Other No. Employees ☑ Public


No. Nitrification Fields: No. Lines Linear Feet Repair System Description: SEPTIC TANK, CONV. GRAV. ☐ Slab ☐ Crawl Space ☐ Community

Trench Width Max. Trench Bottom Depth Gravel Depth Maintenance Agreement Required ☐ YES ☑ NO ☑ GRAVITY ☐ PRESSURE ☐ Basement w/plumbing ☐ Basement w/o plumbing


Comments / Conditions REPLACE EXISTING CRUSHED SEPTIC TANK WITH NEW S.T. AT LOCATION SHOWN.

SEPTIC TANK WITH MARKER INSTALLED USING RED "POLYLOK" FILTER

INITIAL SITE SKETCH

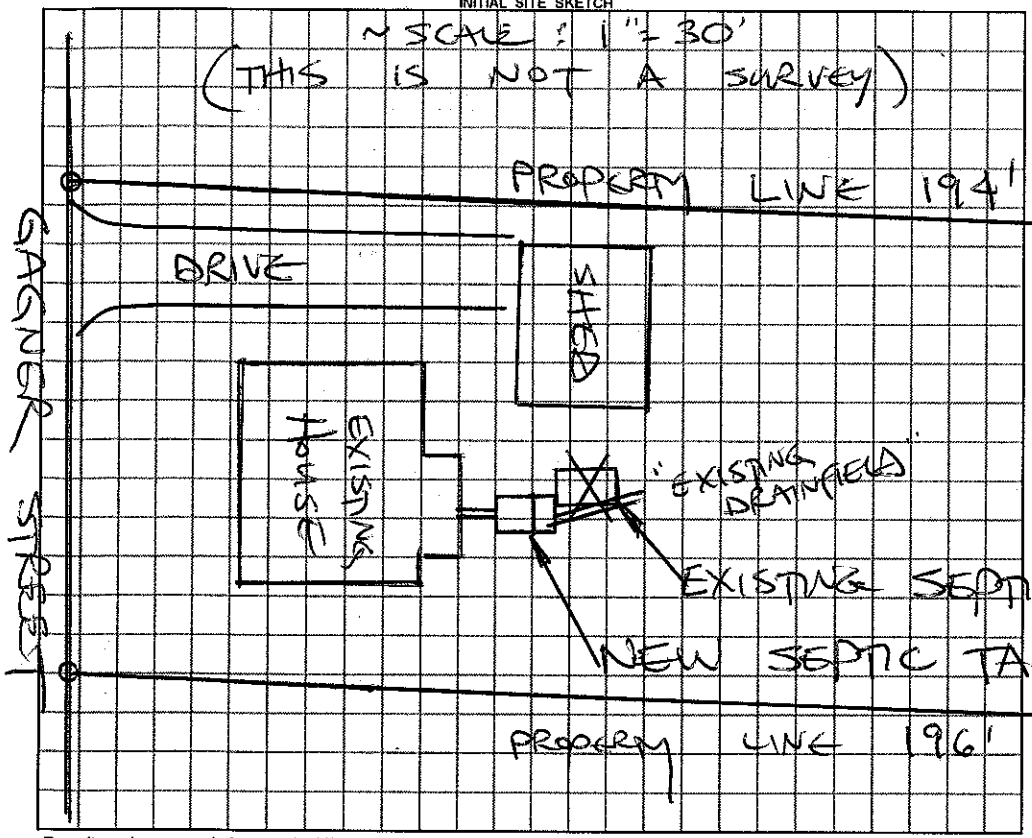

AS BUILT SKETCH

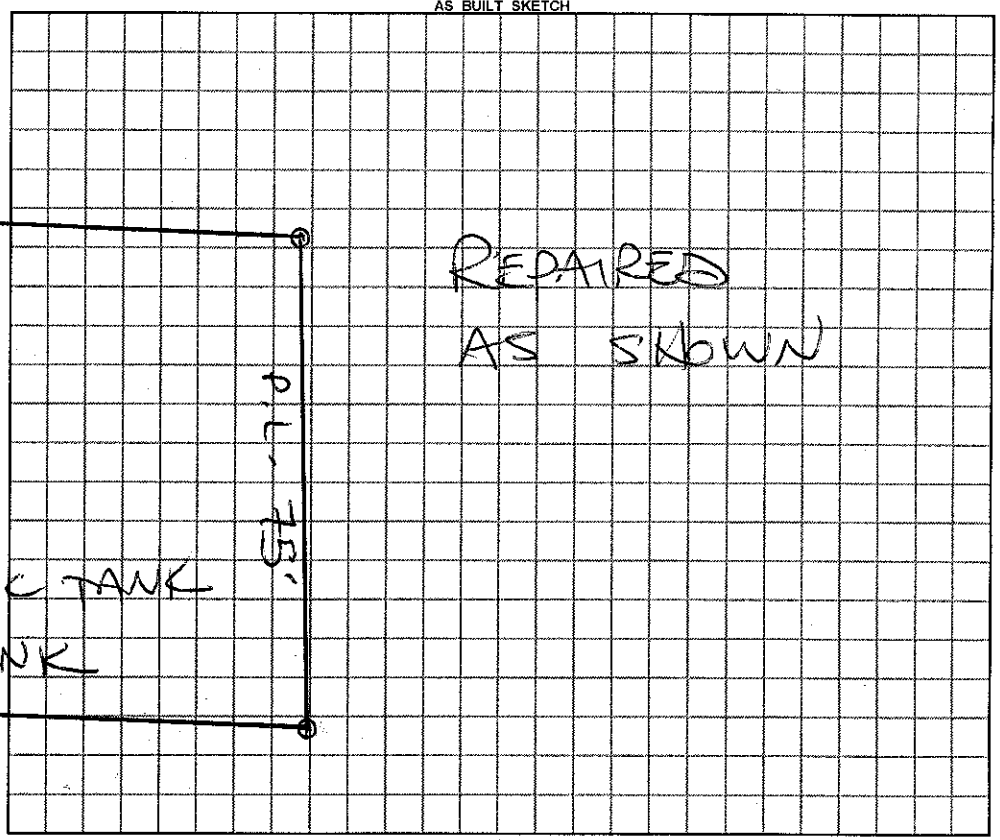

Permit can be suspended or revoked if any false information is supplied toward securing the permit / any unauthorized changes are made to the site / any unauthorized changes are made in the installation of the system.

☐ ***IMPROVEMENT PERMIT*** with plat valid without expiration. ☐ ***IMPROVEMENT PERMIT*** with plat valid without expiration. ☐ ***AUTHORIZATION TO CONSTRUCT*** valid for period equal to IMPROVEMENT PERMIT--not to exceed 60 mo.

Owner / Applicant Signature: Date 11-24-10 Installed by: RANDY MILLER & SONS

IMPROVEMENT PERMIT by: STEVE HEDRICK REHS Date 11-23-2010 OPERATION PERMIT by: STEVE HEDRICK REHS Date 11-24-2010

AUTHORIZATION TO CONSTRUCT by: STEVE HEDRICK REHS Date 11-23-2010 Existing System Inspected by: REHS Date

YOU SHOULD CONTACT A LOCATOR SERVICE PRIOR TO ANY EXCAVATION

White Copy -- Environmental Health YELLOW COPY (Final) Owner / Applicant PINK COPY (Initial) Owner / Applicant