IREDELL COUNTY HEALTH DEPARTMENT

STATESVILLE 704-878-5305 MOORESVILLE 704-664-5281

IMPROVEMENT PERMIT / CERTIFICATE OF COMPLETION / OPERATION PERMIT / EXISTING SYSTEM INSPECTION

PROPERTY DESCRIPTION NO. Repair DATE 6-17-93 TAX MAP NO. Repair

OWNER OR CONTRACTOR Herbert & Evelyn Kelso PHONE: Business Home 872-3648

ADDRESS 2012 Gagner St. Statesville, N.C. 28677

LOCATION I40W TL Hwy 90 TR Hwy 70 TL Greir St TR Gagner street 4th house on L.

SUBDIVISION NA BLOCK / SECTION LOT LOT AREA Ample SITE CLASS. P.S. L.T.A.R. Existing

Water Supply: ☐ Individual ☐ Community ☑ Public City Water

Septic Tank: Existing Gallons: STB Date

Pump Tank: Gallons: PT Date

Nitrification Field: No Fields 2 Square Feet 720 Linear Feet 9' x 80'

No Lines 3 Trench Width 9' Trench Depth 36" Gravel Depth 18"

☐ New System ☑ Repair System Type: I (II) II, IV, V, VI

System Description: conventional ; gravity "

Repair System Description: "

Maintenance Agreement Required: ☐ Yes ☑ No

☐ House/Mod. Home ☐ Mobile Home ☐ Business ☐ Other

No. Bedrooms 2 No. Bathrooms 1 No. Employees —

☐ Slab ☑ Crawl Space ☐ Basement w/plumbing ☐ Basement wo/plumbing

Garbage Disposal: ☐ Yes ☑ No


Auto. Dishwasher: ☐ Yes ☑ No

Auto. Washing Machine: ☑ Yes ☐ No


Other

Comments Install 9' x 80' Bed system. Keep bed 6' from existing drain field, 5' from foundation of house, and 10' from all property lines. Keep Bed on contour and install no deeper than 36" to bottom of trench.

INITIAL SITE SKETCH

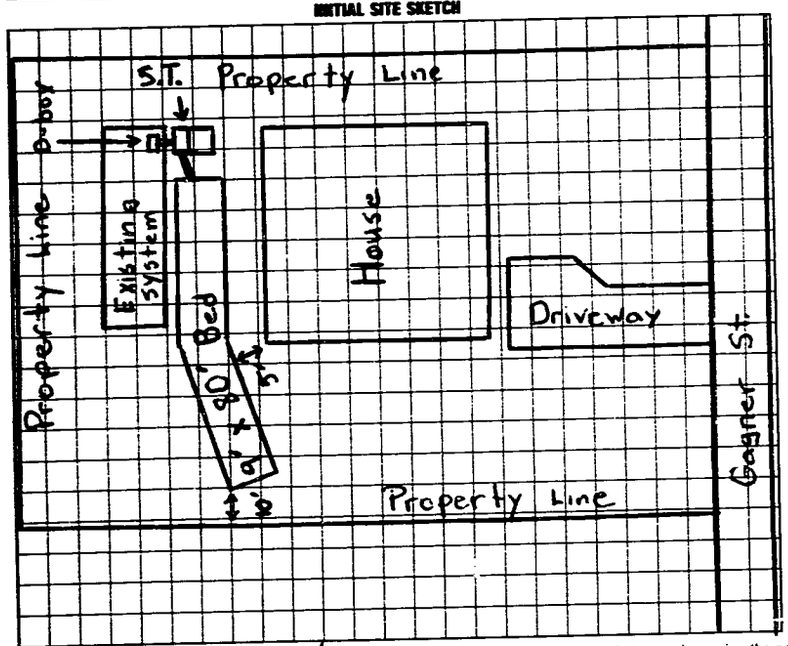

AS BUILT SKETCH

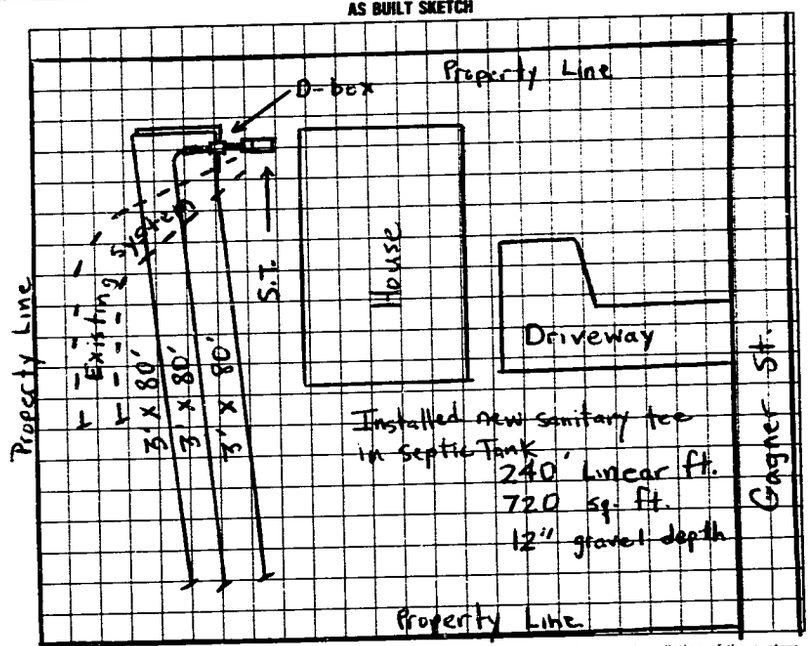

I understand that this permit can be suspended or revoked if any false information is supplied toward securing the permit/any unauthorized changes are made to the site/any unauthorized changes are made in the installation of the system. Improvement Permit is valid for 60 months from date of issuance.

Signed: Evelyn Kelso

Improvement Permit by: Michael J. Dennis date 6-17-93

Existing System Inspection by: date

Installed by: A-1 Backhoe

Certificate of Completion by: Michael J. Dennis date 7-1-93

Operation Permit by: date

HEALTH DEPT. COPY: WHITE INSPECTION COPY (FINAL): GREEN OWNER COPY (FINAL): YELLOW INSPECTION COPY (INITIAL): PINK OWNER COPY (INITIAL): GOLD