IREDELL COUNTY HEALTH DEPARTMENT

STATESVILLE 704-878-5305 MOORESVILLE 704-664-5281

IMPROVEMENT PERMIT / AUTHORIZATION TO CONSTRUCT / OPERATION PERMIT / EXISTING SYSTEM INSPECTION

PERMIT# Repair PIN#

OWNER OR CONTRACTOR Robert Foote PHONE: Business Home (704) 528-3066 DATE 5/22/01

ADDRESS P.O. Box 861 Statesville NC 28687

LOCATION From St to (L) Park Drive, (R) on Cagner = 2010 Cagner Street on Right

SUBDIVISION Eastern BLOCK / SECTION LOT LOT AREA SITE CLASS DESIGN FLOW L.T.A.R.

Septic Tank: 1000 Gallons: STB Date

Pump Tank: Gallons: PT Date

Pump Make: Model Serial No.

Nitrification Field: No. Fields 1 Square Feet Linear Feet

No. Lines 3 of 3 Trench Width Max Trench Bottom Depth Gravel Depth 19"

☐ New System ☒ Repair System Type: ☐ I ☒ II ☐ III ☐ IV ☐ V ☐ VI

System Description: Bed System

Repair System Description: Bed System

Maintenance Agreement Required: ☐ Yes ☒ No

☒ House/Mod. Home No. Bedrooms 3

☐ Mobile Home No. Bathrooms 2

☐ Business No. Employees

☐ Other


☐ Slab ☐ Crawl Space ☐ Basement w/plumbing ☐ Basement wo/plumbing

Water Supply: ☐ Individual ☐ Public ☐ Community


Comments/Conditions: Original Permit - Sheriff Lander Co - 9-5-69 ~~[illegible]~~ 95 Lin. Ft. Bed System ① Abandon old bed System + box ② Install New dist box and three Line +/- 95 Ft Long in bed with 19" gravel.

Comments/Conditions: - Installed 18" Gravel - Installed New Tee in Tank

INITIAL SITE SKETCH Not to Scale

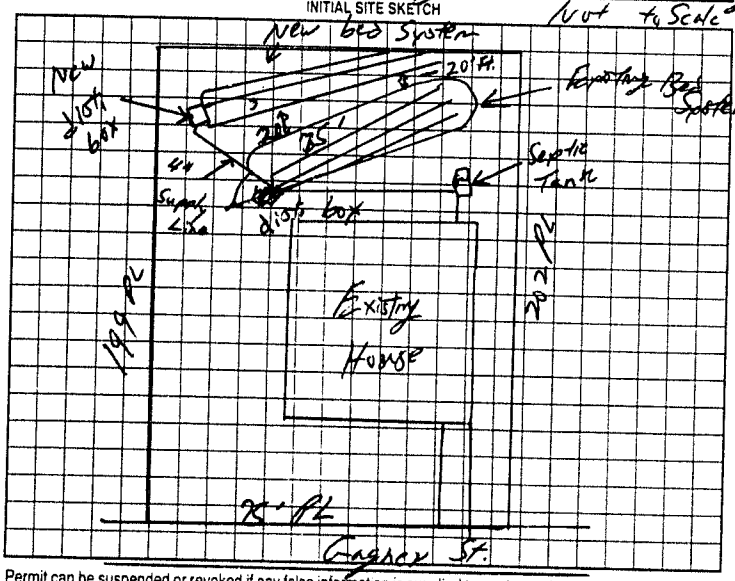

AS BUILT SKETCH

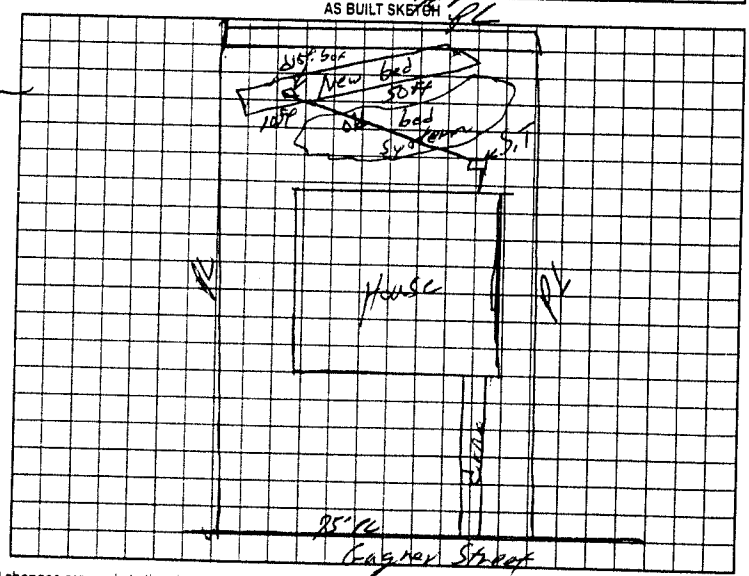

Permit can be suspended or revoked if any false information is supplied toward securing the permit/any unauthorized changes are made to the site/any unauthorized changes are made in the installation of the system. Improvement Permit with plan valid without expiration. Improvement Permit with site plan valid for sixty months. Authorization to Construct is valid for a period equal to that of Improvement Permit – not to exceed sixty months.

Signed: Robert Foote date

Improvement Permit by: William O. Johnson date 5/24/01

Authorization to Construct by: William O. Johnson date 5/24/01

Installed by: James Hasler

Operation Permit by: William O. Johnson date 7/20/01

Existing System Inspection by: date

HEALTH DEPT. COPY: WHITE OWNER COPY (FINAL): YELLOW OWNER COPY (INITIAL): PINK