IREDELL COUNTY HEALTH DEPARTMENT

Statesville Phone TR 3-7271 . Mocresville Phone No. 664-5281

PERMIT TO INSTALL SEPTIC TANK

Permit No. _____ Permit Date 8-15 19 73

Owner Nellie Fox Address 1915 Rayon St

Installed By Laurence Pearson Address Statesville N.C.

Location of Property


1915 Rayon St.

Tank		Capacity		Length of Lines		Fixtures	
Block	( )	1000	( )	225'	(✓)	No. of Baths	( )
Precast	( )	1250	( )	250'	( )	Dishwasher	( )
		1500	( )	Other _____		Garbage Grdr.	( )
		Other _____				Other _____	

NOTIFY HEALTH DEPARTMENT AT LEAST EIGHT HOURS BEFORE TANK IS TO BE INSPECTED.

Final Inspection 8-15 19 73 Approved (✓) Disapproved ( )

Remarks City Water

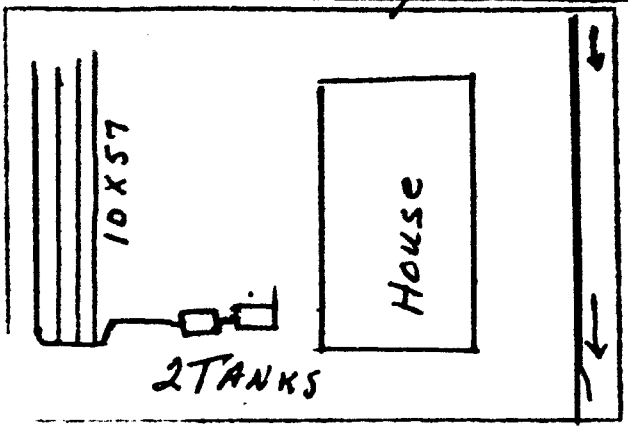

Sketch of Installation

Repair.
Old Tanks Used.
225' New Line.

E. G. Stevenson
Sanitarian