#63862

IREDELL COUNTY HEALTH DEPARTMENT

STATESVILLE 704-878-5305 MOORESVILLE 704-664-5281

IMPROVEMENT PERMIT / CERTIFICATE OF COMPLETION / OPERATION PERMIT / EXISTING SYSTEM INSPECTION

PROPERTY DESCRIPTION NO. Statesville City DATE 8-15-96 TAX MAP NO. 6E-A-52 Watershed: ☐ Yes ☐ No

OWNER OR CONTRACTOR Danny Johnson PHONE: Business 876-9104 Home [redacted]

ADDRESS 744 Buffalo Shoals Rd

LOCATION Buffalo Shoals Rd on RT inside Skating Rink 1/4mi from city limits

SUBDIVISION _____ BLOCK / SECTION _____ LOT _____ LOT AREA 14+ acres SITE CLASS. _____ DESIGN FLOW 100 L.T.A.R. .25

Septic Tank: 1000 Gallons; STB 794 Date 11-18-96

Pump Tank: _____ Gallons; PT _____ Date _____

Pump Make: _____ Model _____ Serial No. _____

Nitrification Field: No Fields 1 Square Feet 450 Linear Feet 150

No Lines 3 Trench Width 36" Max Trench Bottom Depth 36" Gravel Depth 12"

☐ New System ☐ Repair System Type: I (II) III, IV, V, VI

System Description: Conv. Gravity

Repair System Description: " "

Maintenance Agreement Required ☐ Yes ☑ No

☐ House/Mod. Home No. Bedrooms ___

☐ Mobile Home No. Bathrooms ___

☑ Business No. Employees ___

☐ Other Office for mini


☐ Slab ☐ Crawl Space ☑ Basement w/plumbing ☐ Basement w/o plumbing

Water Supply: ☑ Individual ☐ Community ☐ Public


Comments:

Comments: Sow Grass back over area of S.T. System + Keep mowed.

INITIAL SITE SKETCH

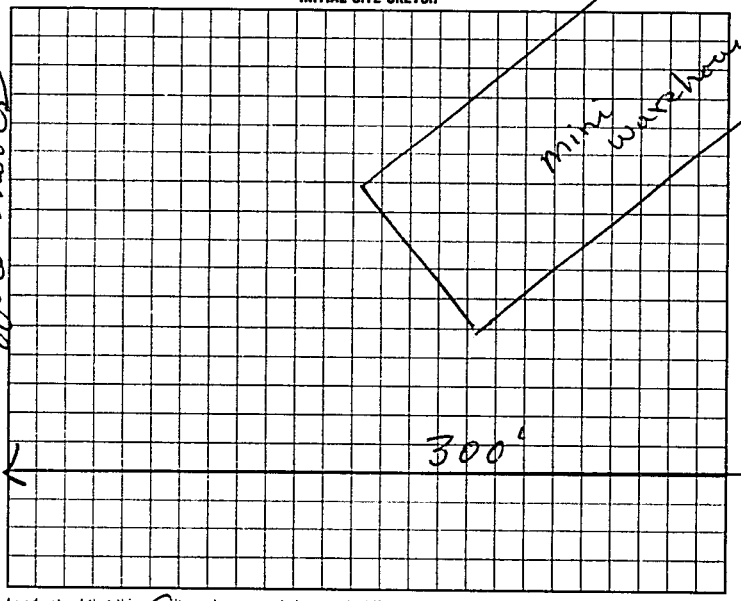

AS BUILT SKETCH

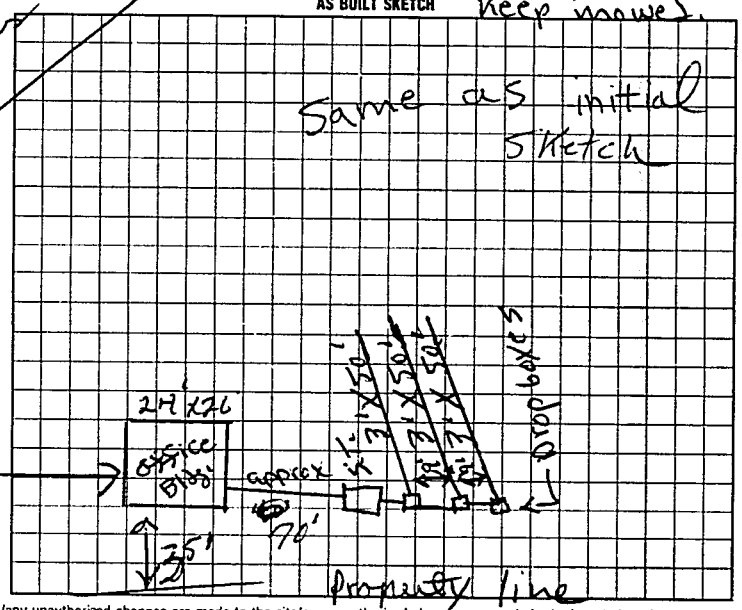

I understand that this permit can be suspended or revoked if any false information is supplied toward securing the permit/any unauthorized changes are made to the site/any unauthorized changes are made in the installation of the system.

Signed: X Danny Johnson

Improvement Permit by: P.C. Moore date 8-15-96

Authorization to Install by P.C. Moore date 8-15-96

Installed by: Wes Fytton

Certificate of Completion by: _____ date _____

Operation Permit by: P.C. Moore date 1-21-97

Authorization to Const Expires 6 mos from issue

INSPECTION COPY (FINAL). WHITE OWNER COPY (FINAL). YELLOW INSPECTION COPY (INITIAL). PINK OWNER COPY (INITIAL). GOLD

986000