IREDELL COUNTY HEALTH DEPARTMENT

STATESVILLE 704-878-5305 MOORESVILLE 704-664-5281

IMPROVEMENT PERMIT / AUTHORIZATION TO CONSTRUCT / OPERATION PERMIT / EXISTING SYSTEM INSPECTION

PERMIT# ____ PIN# ____ DATE 4-7-99

OWNER OR CONTRACTOR Metro Mont Concrete PHONE: Business 878-[redacted]6156 Home ____

ADDRESS 1125 Johnson Drive Statesville N.C.

LOCATION Buffalo Shoals Rd Turn on Johnson Drive last business on left

SUBDIVISION ____ BLOCK / SECTION ____ LOT ____ LOT AREA 10 acres SITE CLASS PS DESIGN FLOW 500 L.T.A.R. .35

Septic Tank: 1500 Gallons; STB ____ Date ____

Pump Tank: ____ Gallons; PT ____ Date ____

Pump Make: ____ Model ____ Serial No. ____

Nitrification Field: No Fields 1 Square Feet 1500 Linear Feet 500

No Lines 5 Trench Width 36" Max Trench Bottom Depth 36" Gravel Depth 12"

☐ New System ☑ Repair System Type: I. II. III. IV. V. VI

System Description: ____

Repair System Description: Conv. Gravity

Maintenance Agreement Required: ☐ Yes ☐ No

☐ Slab ☐ Crawl Space ☐ Basement w/plumbing ☐ Basement wo/plumbing

☐ House/Mod. Home No. Bedrooms ____

☐ Mobile Home No. Bathrooms ____

☑ Business No. Employees 20

☐ Other ____


Water Supply: ☐ Individual ☐ Public ☐ Community

Comments/Conditions:


Comments/Conditions

Replace permit issued 3-8-99

INITIAL SITE SKETCH

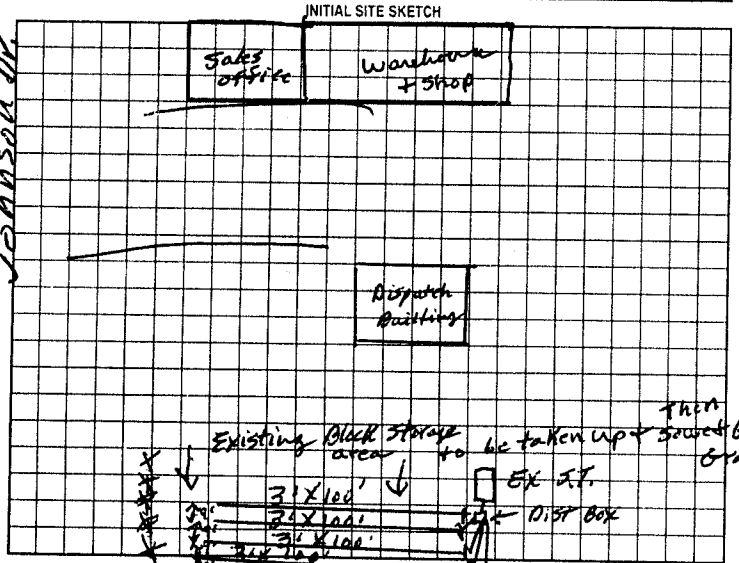

AS BUILT SKETCH

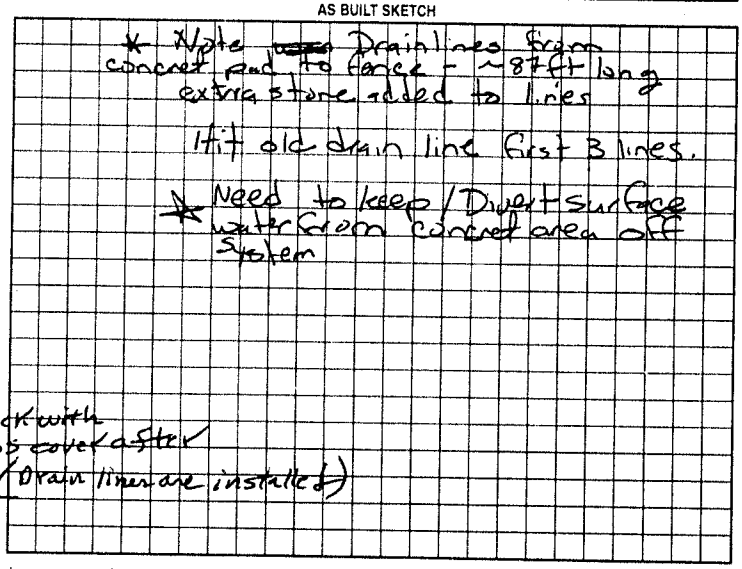

Permit can be suspended or revoked if any false information is supplied toward securing the permit/any unauthorized changes are made to the site/any unauthorized changes are made in the installation of the system. Improvement Permit with plat valid without expiration. Improvement Permit with site plan valid for sixty months. Authorization to Construct is valid for a period equal to that of Improvement Permit – not to exceed sixty months.

Signed: ____ date ____ Installed by: Chain link fence Scott Greene

Improvement Permit by: R. C. Moore date 4-7-99 Operation Permit by: Mat C. Offs date 4-22-99

Authorization to Construct by: R. C. Moore date 4-7-99 Existing System Inspection by: ____ date ____

HEALTH DEPT COPY WHITE OWNER COPY (FINAL) YELLOW OWNER COPY (INITIAL) PINK