IREDELL COUNTY HEALTH DEPARTMENT

Statesville Phone TR 3-7271 Mooresville Phone No. 664-5281

PERMIT TO INSTALL SEPTIC TANK

Permit No. 308 Permit Date 2-26 1973

Owner Johnson Construction Co Address Statesville NC

Installed By Raymond Adams Address Hiddenite NC

Location of Property Out Buffalo Shoals Rd.
Office and Garage on R. Just outside
City limits. Layout By Mr Johnson


Tank		Capacity		Length of Lines		Fixtures	
Block	( )	1000	( )	225'	( )	No. of Baths	(3)
Precast	(✓)	1250	(✓)	250'	( )	Dishwasher	( )
		1500	( )	Other 300'		Garbage Grdr.	( )
		Other		900 sq ft		Other	

NOTIFY HEALTH DEPARTMENT AT LEAST EIGHT HOURS BEFORE TANK IS TO BE INSPECTED.

Final Inspection 6-26 1973 Approved (✓) Disapprcved ( )

Remarks No Well Down Yet.

40 Ton Stone

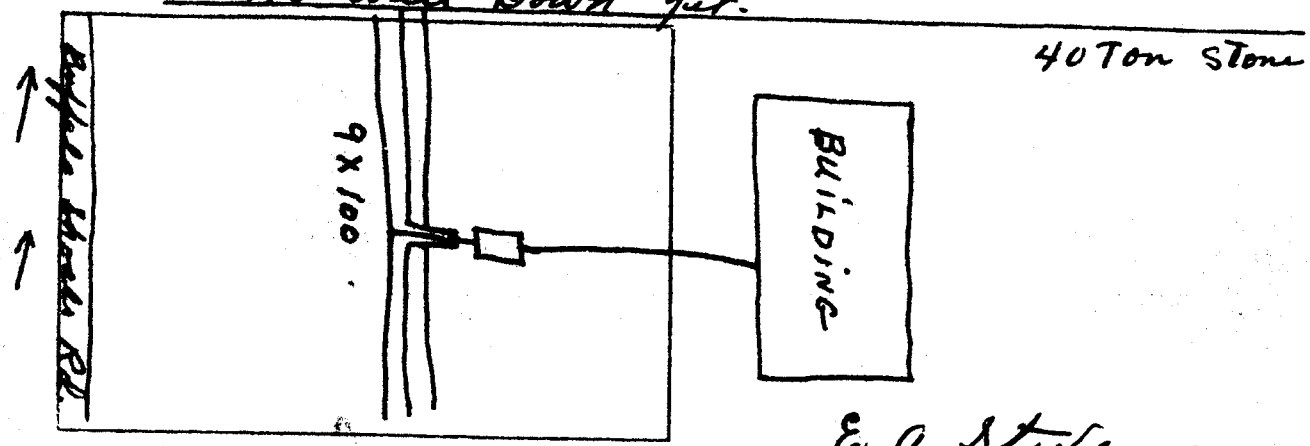

Sketch of Installation

E. A. Stevenson
Sanitarian