IREDELL COUNTY HEALTH DEPARTMENT

STATESVILLE 704-878-5305 MOORESVILLE 704-664-5281

IMPROVEMENT PERMIT / AUTHORIZATION TO CONSTRUCT / OPERATION PERMIT / EXISTING SYSTEM INSPECTION

PERMIT# STATESVILLE PIN# 4734 40 3175 DATE 5-11-01

OWNER OR CONTRACTOR BUILDING MATERIAL WHOLESALE RETAIL PHONE: Business (704) 504-3404 Home (704) 872-1603

ADDRESS 1474 WINSTON AVENUE, STATESVILLE NC

LOCATION BUFFALO SHOALS RD, TL SLINGSHOT RD, TL WINSTON AVE, 1ST TRACT ON LEFT

SUBDIVISION BLOCK / SECTION LOT LOT AREA 4.998 ACRES SITE CLASS PS DESIGN FLOW 200 L.T.A.R. 0.30 GPD/FT²

Septic Tank: 1000 Gallons: STB 1000 Date 5-4-01
Pump Tank: Gallons: PT Date
Pump Make: Model Serial No.
Nitrification Field: No Fields 1 Square Feet 666 Linear Feet 222
No Lines FOUR Trench Width 36" Max Trench Bottom Depth 36" Gravel Depth 12"

☑ New System ☐ Repair System Type: I, II, III, IV, V, VI
System Description: CONVENTIONAL GRAVITY
Repair System Description: CONV. GRAVITY/PUMP
Maintenance Agreement Required: ☐ Yes ☑ No
☑ Slab ☐ Crawl Space ☐ Basement w/plumbing ☐ Basement wo/plumbing


☐ House/Mod. Home No. Bedrooms
☐ Mobile Home No. Bathrooms
☑ Business No. Employees 7
☐ Other WAREHOUSE

Water Supply: ☐ Individual ☑ Public ☐ Community


Comments:/Conditions: ① CONTACT HEALTH DEPT. AFTER CLEARING AND PRIOR TO INSTALLATION TO FLAG OUT DRAINFIELD ② KEEP SYSTEM MINIMUM 100 FEET FROM ANY WELL

Comments:/Conditions: SEPTIC TANK WITH RISERS INSTALLED USING "POLYLOK" FILTER

INITIAL SITE SKETCH

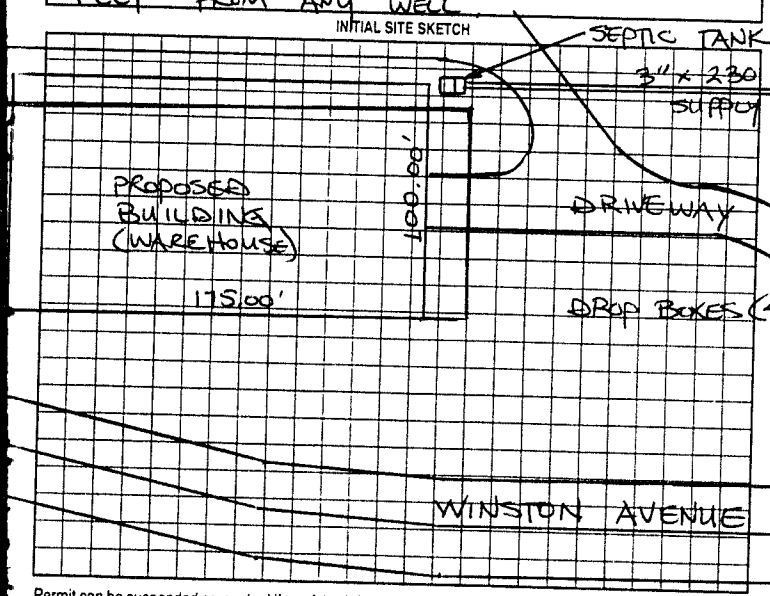

AS BUILT SKETCH

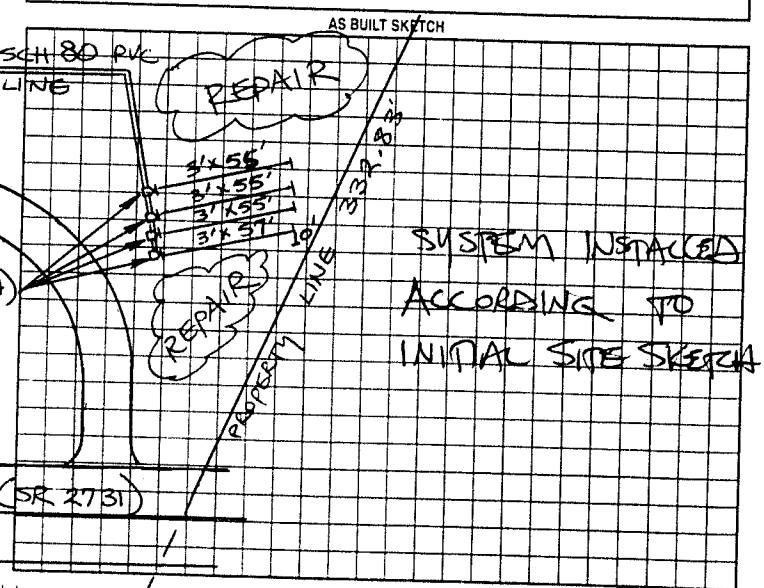

Permit can be suspended or revoked if any false information is supplied toward securing the permit/any unauthorized changes are made to the site/any unauthorized changes are made in the installation of the system. Improvement Permit with plat valid without expiration. Improvement Permit with site plan valid for sixty months. Authorization to Construct is valid for a period equal to that of Improvement Permit – not to exceed sixty months.

Signed: Jerry Hedrick date 5/11/01 Installed by: JAMES HUDLER

Improvement Permit by: STEVE HEDRICK date 5-11-01 Operation Permit by: STEVE HEDRICK date 7-18-01

Authorization to Construct by: STEVE HEDRICK date 5-11-01 Existing System Inspection by: date

HEALTH DEPT COPY WHITE OWNER COPY (FINAL) YELLOW OWNER COPY (INITIAL) PINK