IREDELL COUNTY HEALTH DEPARTMENT

Statesville Phone TR 3-7271 Mooresville Phone NO 3-1271

PERMIT TO INSTALL SEPTIC TANK

Permit NO. _____ Permit Date June 19 1968

Owner John B. Earle Address 220 Ridgeway Ave.

Installed By C Hoke Address R7


Location of Property City -

Tank		Capacity		Length of Lines		Fixtures	
Block	( )	1000	(✓)	225'	(✓)	No. of Baths	(2)
Precast	(✓)	1250	( )	250'	( )	~~Dishwasher~~	( )
Adams.		1500	( )	Other _____		~~Garbage Grdr.~~	( )
		Other _____				Other stools	

NOTIFY HEALTH DEPARTMENT AT LEAST EIGHT HOURS BEFORE TANK IS TO BE INSPECTED.

Final Inspection _____ 19__. Approved ( ) Disapproved ( )

Remarks City water - wooded - may have root problem from poplar trees - new house main part to go on city sewer.

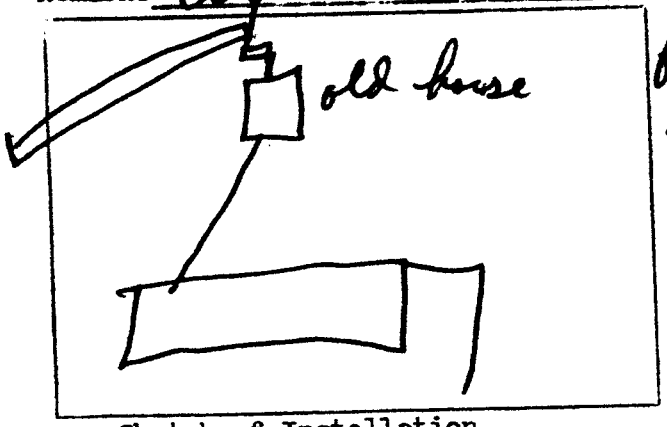

Sketch of Installation

Sanitarian