IREDELL COUNTY HEALTH DEPARTMENT

Statesville Phone TR 3-7271 Mooresville Phone NO 3-1271

PERMIT TO INSTALL SEPTIC TANK

Permit NO._____ Permit Date March 5 19 67

Owner Silverstein Bros Inc Address _____

Installed By W. F. Hudson Address _____

Location of Property Lot #6 Lake Davis Estates on N. Side


No Farm on dirt road thru subdivision

Tank	Capacity	Length of Lines	Fixtures
Block ( )	800 ( )	150' ( )	No. of Baths (4)
Precast (4)	900 ( )	175' ( )	Dishwasher ( )
	1000 ( )	200' ( )	Garbage Grdr. ( )
	1100 ( )	225' ( )	Auto-Washer ( )
	1200 ( )	250' ( )	Other Laundry
	Other 1250 gal.	Other 325'	

NOTIFY HEALTH DEPARTMENT AT LEAST EIGHT HOURS BEFORE TANK IS TO BE INSPECTED.

Final Inspection 3 - 4 19 67 Approved (4) Disapproved ( )

Remarks _____

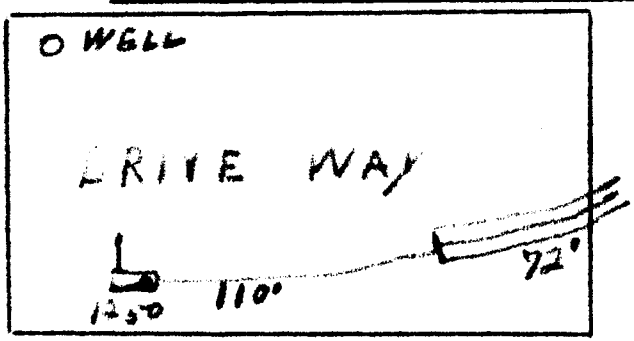

Sketch of Installation

W. F. Hudson + R. M. Jenson

Sanitarian