IREDELL COUNTY HEALTH DEPARTMENT

STATESVILLE 704-878-5305 (R) (R) MOORESVILLE 704-664-5281

A

IMPROVEMENT PERMIT / AUTHORIZATION TO CONSTRUCT / OPERATION PERMIT / EXISTING SYSTEM INSPECTION

PERMIT # 160505 PIN # 4735-05-3113 DATE 3-30-10

OWNER or APPLICANT James & Debra Sharpe PHONE: Business 704 941-5307 (Vinnie) Home:

OWNER or APPLICANT ADDRESS 840 Kentwood

LOCATION / DIRECTIONS 186 Bradley Farm Rd.

SUBDIVISION n/a BLOCK / SECTION n/a LOT # LOT AREA .64 Ac. DESIGN FLOW 360 L.T.A.R. .3

Septic Tank 1000 Gallons: STB Date 11-39

Pump Tank Gallons: PT Date

Pump Make Model Serial #

Nitrification Field No Fields 1 No Lines 5 Linear Feet 300'

Trench Width 36" Max. Trench Bottom Depth 36" Gravel Depth n/a

☒ New System ☐ Repair ☐ Expansion System Type I II III IV V VI

System Description: 25% Reduction Gravity

Repair System Description: 50% Reduction Pump

Maintenance Agreement Required ☐ YES ☒ NO

☒ GRAVITY ☐ PRESSURE


☒ Residence No. Bedrooms 3 ☐ Business No. Persons ☐ Other No. Employees ☐ Slab ☒ Crawl Space ☐ Basement w/plumbing ☐ Basement w/o plumbing

Water Supply ☐ Private ☒ Public ☐ Community

Comments / Conditions


1"=50'

INITIAL SITE SKETCH

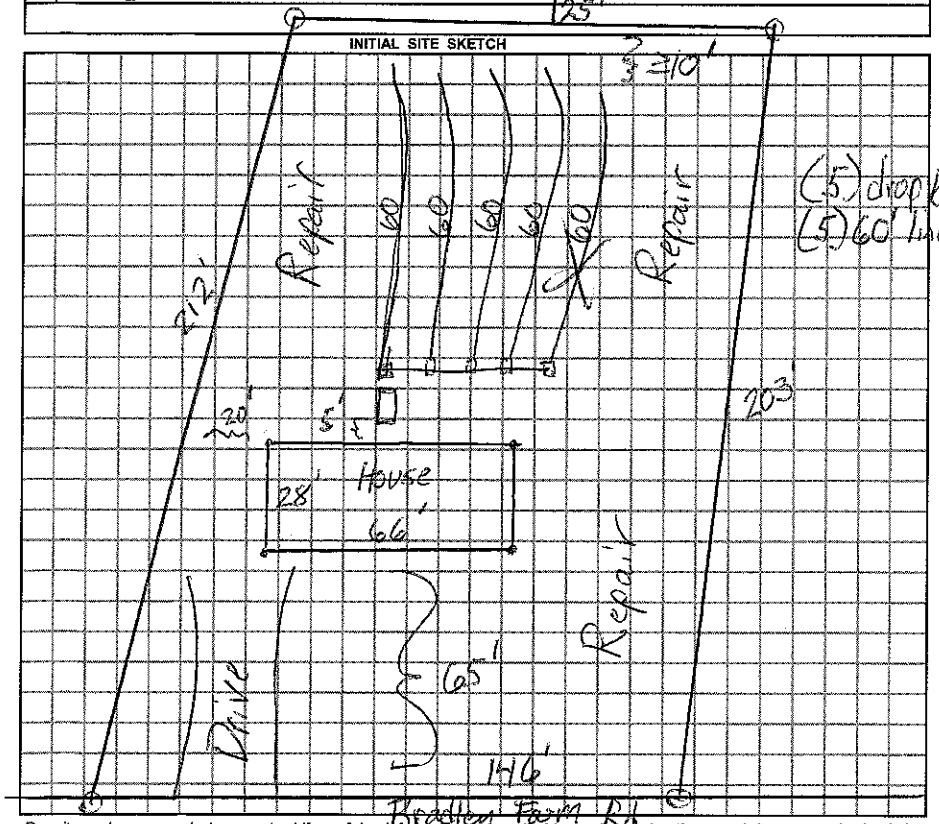

Comments / Conditions

AS BUILT SKETCH

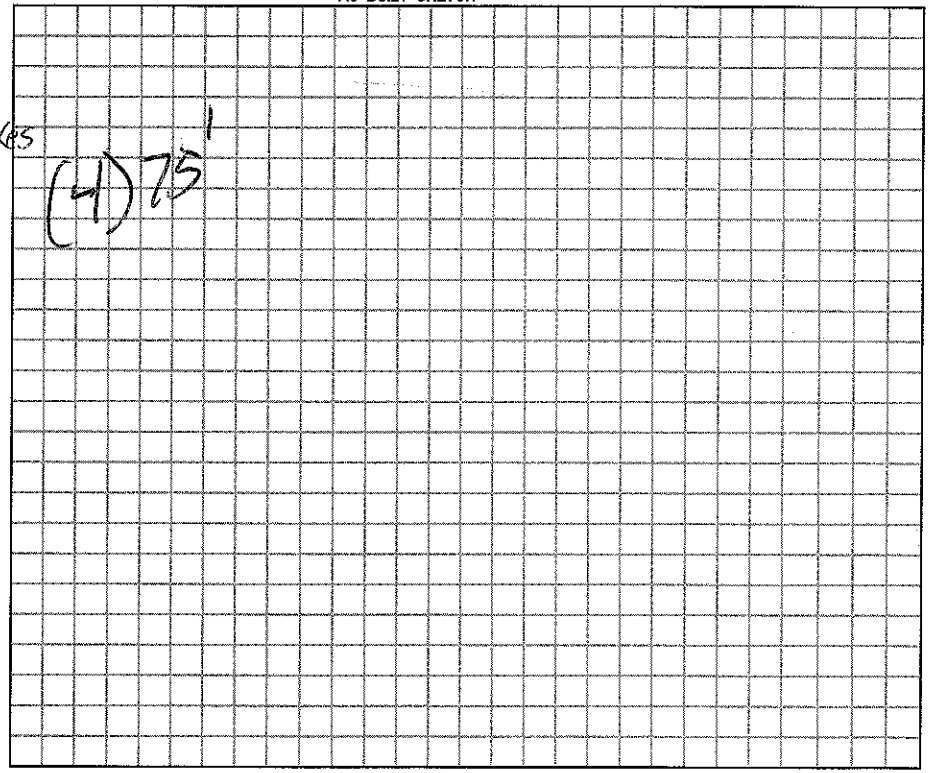

Permit can be suspended or revoked if any false information is supplied toward securing the permit / any unauthorized changes are made to the site / any unauthorized changes are made in the installation of the system.

☐ *IMPROVEMENT PERMIT w / plat valid without expiration* ☒ *IMPROVEMENT PERMIT w / site plan valid for 60 mos.* ☒ *AUTHORIZATION TO CONSTRUCT valid for period equal to IMPROVEMENT PERMIT-not to exceed 60 mo.*

Owner / Applicant Signature: Date 4-12-10 Installed by: Abee Gradick

Improvement Permit by: Date 3-30-10 Operation Permit by: Date: 5-20-10

Authorzation to Construct by: Date 3-30-10 Existing System Inspected by: Date:

YOU SHOULD CONTACT A LOCATOR SERVICE PRIOR TO ANY EXCAVATION.

WHITE COPY Environmental Health YELLOW COPY (Final) Owner / Applicant PINK COPY (Initial) Owner / Applicant