IREDELL COUNTY HEALTH DEPARTMENT

STATESVILLE 704-878-5305 MOORESVILLE 704-664-5281

IMPROVEMENT PERMIT / CERTIFICATE OF COMPLETION / OPERATION PERMIT / EXISTING SYSTEM INSPECTION

PROPERTY DESCRIPTION NO. _____ DATE 8-20-97 TAX MAP NO. 4735-05-3535 Watershed: ☐ Yes ☐ No

OWNER OR CONTRACTOR Kenneth MCCANN PHONE: Business 881-6593 Home _____

ADDRESS 317 Grassy Knob Rt union Grove

LOCATION 115 N TL old 115 TL Bradley Rd TR Sara Ln 400' left

SUBDIVISION Country Living BLOCK / SECTION _____ LOT 16 LOT AREA 18,518.4 SITE CLASS. PS DESIGN FLOW 360 L.T.A.R. .3

Septic Tank: 1000 Gallons; STB 794 Date 9-2-97

Pump Tank: _____ Gallons; PT _____ Date _____

Pump Make: _____ Model _____ Serial No. _____

Nitrification Field: No Fields 1 Square Feet 1200 Linear Feet 400

No Lines 6 Trench Width 36" Max Trench Bottom Depth 36" Gravel Depth 12"

☑ New System ☐ Repair System Type: I, ☑ II, III, IV, V, VI

System Description: Conv. Gravity

Repair System Description: Pump To Chambers

Maintenance Agreement Required: ☐ Yes ☑ No

☑ House/Mod. Home ☐ Mobile Home ☐ Business ☐ Other

No. Bedrooms 3 No. Bathrooms 2 No. Employees _____


☐ Slab ☑ Crawl Space ☐ Basement w/plumbing ☐ Basement wo/plumbing

Water Supply: ☐ Individual ☐ Community ☑ Public

Comments:

Comments: DO NOT Route water line with in 10' of any part of Septic Tank System

INITIAL SITE SKETCH

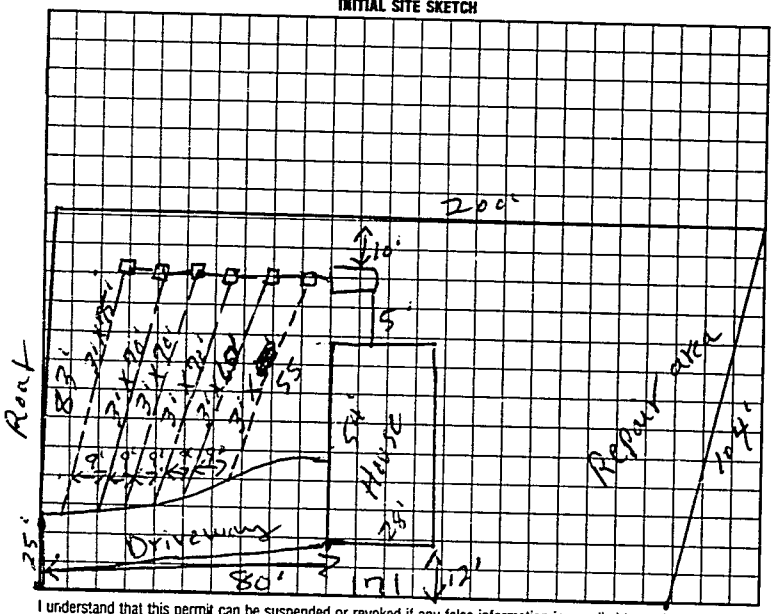

AS BUILT SKETCH

DO Not Place Driveway over Drain lines

Same as initial Sketch

I understand that this permit can be suspended or revoked if any false information is supplied toward securing the permit/any unauthorized changes are made to the site/any unauthorized changes are made in the installation of the system. Improvement Permit is valid for 60 months from date of issuance.

Signed: Kenneth McCann

Improvement Permit by: R. C. Moore date 8-20-97

~~Existing System Inspection~~ Authorization to Connect by: R. C. Moore date 8-20-97

Installed by: James Hutler

Certificate of Completion by: _____ date _____

Operation Permit by: R. C. Moore date 12-15-97

HEALTH DEPT COPY: WHITE INSPECTION COPY (FINAL): GREEN OWNER COPY (FINAL): YELLOW INSPECTION COPY (INITIAL): PINK OWNER COPY (INITIAL): GOLD

Authorization to Connect Expires 40 mos from issue