089801

IREDELL COUNTY HEALTH DEPARTMENT

STATESVILLE 704-878-5305 MOORESVILLE 704-664-5281

IMPROVEMENT PERMIT / AUTHORIZATION TO CONSTRUCT / OPERATION PERMIT / EXISTING SYSTEM INSPECTION

DATE 5-9-00

PERMIT# CITY PIN#

OWNER OR CONTRACTOR KENNETH McCANN PHONE: Business 592-7571 Home

ADDRESS 317 GRASSY KNOB ROAD, UNION GROVE, NC 28689

LOCATION NC 115 N, TL OLD WILKESBORO RD, TL BRADLEY FARM RD, TR SARA LANE, 2ND LOT ON RIGHT

SUBDIVISION COUNTRY LANDING BLOCK / SECTION LOT 2 LOT AREA 17,860± SF SITE CLASS PS DESIGN FLOW 360 L.T.A.R. 0.25 GPD/FT²

Septic Tank: 1000 Gallons; STB 1012 Date 4/18/02
Pump Tank: Gallons; PT Date
Pump Make: Model Serial No.
Nitrification Field: No Fields 1 Square Feet 60 to 1440 Linear Feet 240
No Lines SIX Trench Width 24" Max Trench Bottom Depth 36" Final Depth SAND 6"

☑ New System ☐ Repair System Type: I, II, III, IV, V, VI
System Description: PPBPS, GRAVITY-FED
Repair System Description: PPBPS, LOW PRESS.
Maintenance Agreement Required: ☐ Yes ☑ No

☑ House/Mod. Home ☐ Mobile Home ☐ Business ☐ Other
No. Bedrooms 3 No. Bathrooms 2 No. Employees


Water Supply: ☐ Individual ☑ Public ☐ Community

☐ Slab ☑ Crawl Space ☐ Basement w/plumbing ☐ Basement wo/plumbing


Comments/Conditions: ① INSTALL SUBSURFACE INTERCEPT DRAINAGE DITCH AT LOCATION SHOWN, 48" DEEP OUT TO DAYLIGHT ② USE ONE FLOW DIVIDER TEE TO ACHIEVE EQUAL DISTRIBUTION INTO EACH OF TWO DIST. BOXES FEEDING THREE LINES EACH.

Comments/Conditions: ③ INSTALL FIFTY-FOUR (54) PPBPS PANELS IN SIX EQUAL LENGTH LINES

INITIAL SITE SKETCH

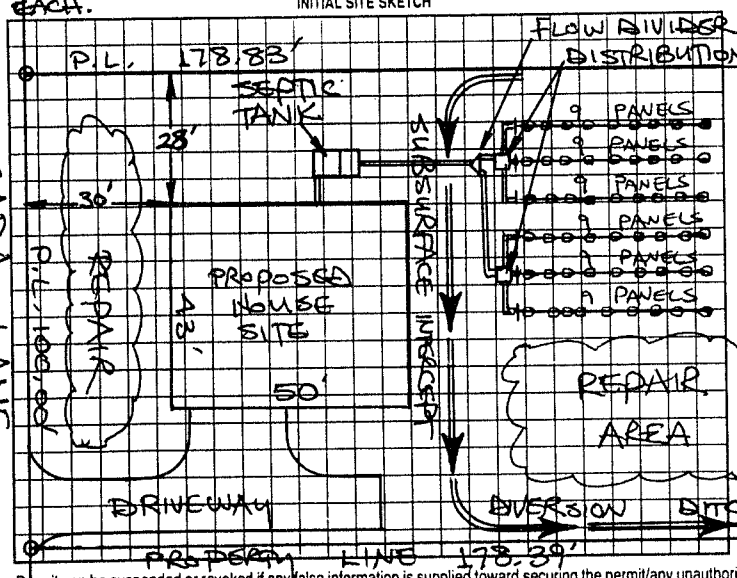

AS BUILT SKETCH

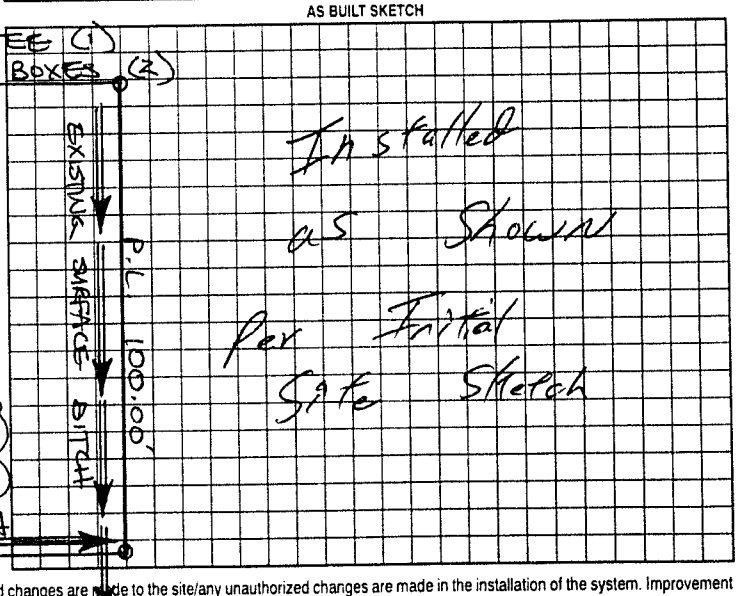

Permit can be suspended or revoked if any false information is supplied toward securing the permit/any unauthorized changes are made to the site/any unauthorized changes are made in the installation of the system. Improvement Permit with plat valid without expiration. Improvement Permit with site plan valid for sixty months. Authorization to Construct is valid for a period equal to that of Improvement Permit – not to exceed sixty months.

Signed: [signature] date 5-15-00 Installed by: Dale Winkler

Improvement Permit by: STEVE HEDRICK date 5-9-00 Operation Permit by: William O. Johnson date 6/26/02

Authorization to Construct by: STEVE HEDRICK date 5-9-00 Existing System Inspection by: date

HEALTH DEPT. COPY: WHITE OWNER COPY (FINAL): YELLOW OWNER COPY (INITIAL): PINK