IREDELL COUNTY HEALTH DEPARTMENT

STATESVILLE 704-878-5305 MOORESVILLE 704-664-5281

IMPROVEMENT PERMIT / AUTHORIZATION TO CONSTRUCT / OPERATION PERMIT / EXISTING SYSTEM INSPECTION

PERMIT# City 79817 PIN# 4735 05 6947 DATE 2-17-99

OWNER OR CONTRACTOR Derek mi Kinney PHONE: Business _____ Home 873 1741

ADDRESS 183 Tree Bark Rd

LOCATION 115N TL off 115N TL Bradley Rd TR Sara Ln at end on Rachel Ln

SUBDIVISION Country Lanta BLOCK / SECTION _____ LOT 10 LOT AREA 26,324.55' SITE CLASS PS DESIGN FLOW 360 L.T.A.R. .3

Septic Tank: 1000 Gallons; STB 312 Date 7-17-99
Pump Tank: _____ Gallons; PT _____ Date _____
Pump Make: _____ Model _____ Serial No. _____
Nitrification Field: No Fields 1 Square Feet 1200 Linear Feet 400
No Lines 4 Trench Width 36" Max Trench Bottom Depth 36" Gravel Depth 12"

~~New System~~ Repair System Type: I. (II.) III. IV. V. VI
System Description: Conv. Gravity
Repair System Description: Gravity 25% Red
Maintenance Agreement Required: Yes ~~No~~


~~House/Mod. Home~~ No. Bedrooms 3
Mobile Home No. Bathrooms 2
Business No. Employees _____
Other _____
Slab ~~Crawl Space~~ Basement w/plumbing Basement wo/plumbing

Water Supply: ☐ Individual ☒ Public ☐ Community


Comments/Conditions:

Comments/Conditions:

INITIAL SITE SKETCH

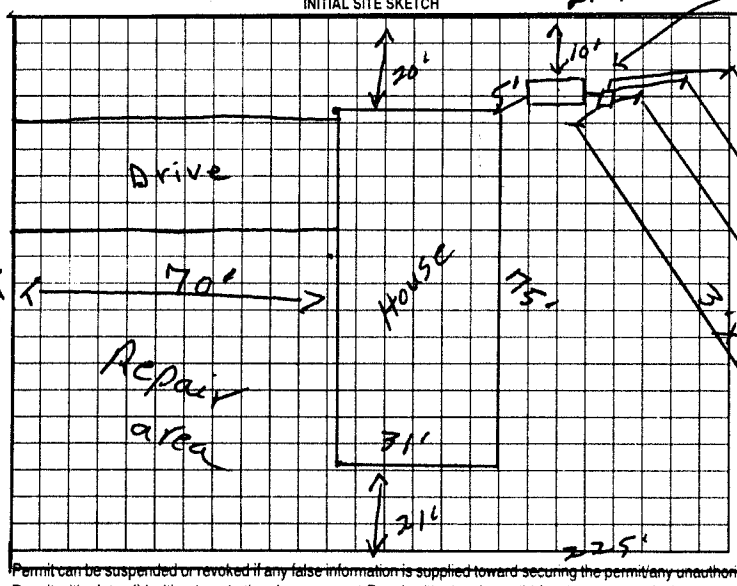

AS BUILT SKETCH

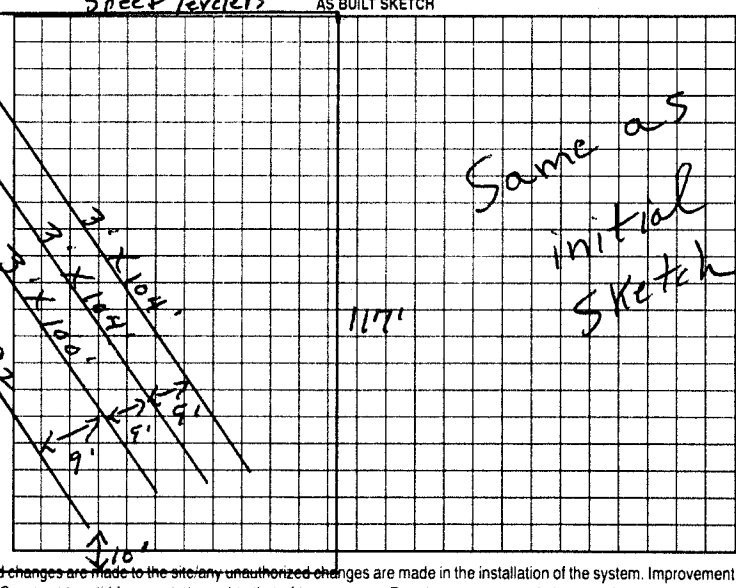

Same as initial Sketch

~~Permit can be suspended or revoked if any false information is supplied toward securing the permit/any unauthorized changes are made to the site/any unauthorized changes~~ are made in the installation of the system. Improvement Permit with plat valid without expiration. Improvement Permit with site plan valid for sixty months. Authorization to Construct is valid for a period equal to that of Improvement Permit – not to exceed sixty months.

Signed: X Derek McKinney date _____ Installed by: Wes Fytton

Improvement Permit by: P.C. Moore date 2-17-99 Operation Permit by: P.C. Moore date 9-1-99

Authorization to Construct by: P.C. Moore date 2-17-99 Existing System Inspection by _____ date _____

HEALTH DEPT COPY WHITE OWNER COPY (FINAL) YELLOW OWNER COPY (INITIAL) PINK