IREDELL COUNTY HEALTH DEPARTMENT

STATESVILLE 704-878-5305 MOORESVILLE 704-664-5281

IMPROVEMENT PERMIT / AUTHORIZATION TO CONSTRUCT / OPERATION PERMIT / EXISTING SYSTEM INSPECTION

PERMIT# STATESVILLE 074772 PIN# 4735-06-3050 DATE 6-29-98

OWNER OR CONTRACTOR KENNETH McCANN PHONE: Business Home 592-7571

ADDRESS 317 GRASSY KNOB ROAD UNION GROVE NC 28689

LOCATION NC 115 N, TL OLD WILKESBORO ROAD, TL BRADLEY FARM TR, SARA LANE, TL RACHEL LANE, AT END

SUBDIVISION COUNTRY LANDING BLOCK / SECTION LOT 12 LOT AREA 32979 SF SITE CLASS PS DESIGN FLOW 360 L.T.A.R. 0.30 GPD/FT

Septic Tank: 1000 Gallons; STB 1012 Date 11-9-98
Pump Tank: Gallons; PT Date
Pump Make: Model Serial No.
Nitrification Field: No Fields 1 Square Feet 1250 Linear Feet 400
No Lines THREE Trench Width 36" Max Trench Bottom Depth 36" Gravel Depth 12"

☑ New System ☐ Repair System Type: ☐ I, II, III, IV, V, VI
System Description: CONVENTIONAL GRAVITY
Repair System Description: CONV. GRAVITY
Maintenance Agreement Required: ☐ Yes ☑ No
☐ Slab ☑ Crawl Space ☐ Basement w/plumbing ☐ Basement wo/plumbing


☑ House/Mod. Home No. Bedrooms 3
☐ Mobile Home No. Bathrooms 2
☐ Business No. Employees
☐ Other

Water Supply: ☐ Individual ☑ Public ☐ Community


Comments:/Conditions:

Comments:/Conditions:
Tank - 1016 on Cover
& Liner

INITIAL SITE SKETCH SCALE: 1"=50'

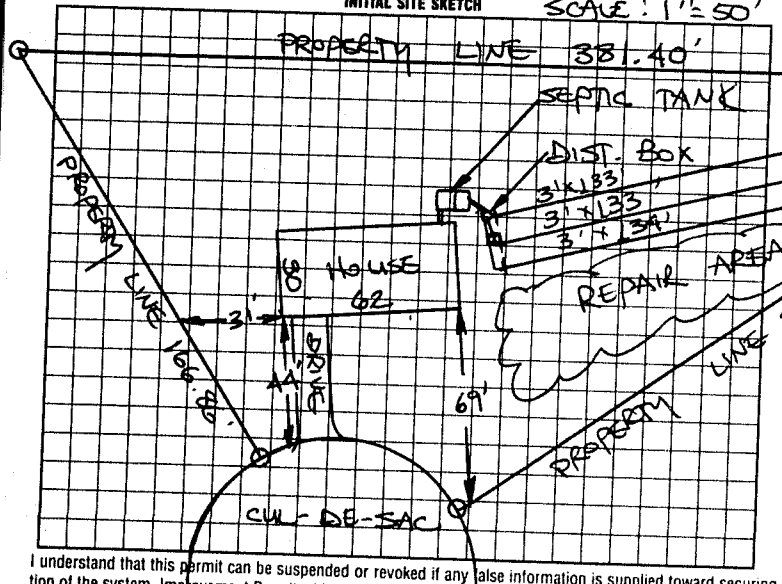

AS BUILT SKETCH

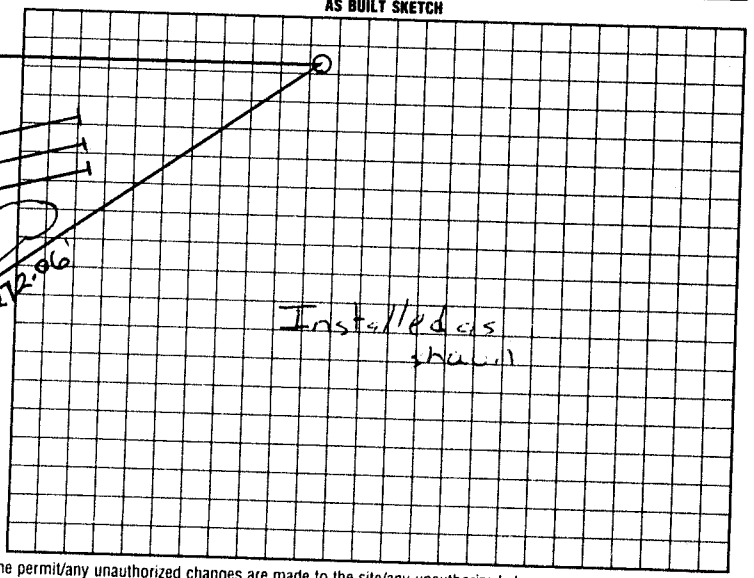

I understand that this permit can be suspended or revoked if any false information is supplied toward securing the permit/any unauthorized changes are made to the site/any unauthorized changes are made in the installation of the system. Improvement Permit with plat valid without expiration. Improvement Permit with site plan valid for sixty months. Authorization to Construct is valid for a period equal to that of Improvement Permit – not to exceed sixty months.

Signed Kenneth McCann date 6-29-98

Improvement Permit by: STEVE HEDRICK date 6.29.98

Authorization to Construct by: STEVE HEDRICK date 6.29.98

Installed by: Bill Adams

Operation Permit by: Hay C. C. RS date 2-23-99

Existing System Inspection by: date

HEALTH DEPT. COPY: WHITE INSPECTION COPY (FINAL): GREEN OWNER COPY (FINAL): YELLOW INSPECTION COPY (INITIAL): PINK OWNER COPY (INITIAL): GOLD