48768

IREDELL COUNTY HEALTH DEPARTMENT

STATESVILLE 704-878-5305 MOORESVILLE 704-664-5281

IMPROVEMENT PERMIT / CERTIFICATE OF COMPLETION / OPERATION PERMIT / EXISTING SYSTEM INSPECTION

PROPERTY DESCRIPTION NO. 6K-A-132 PT (CITY) DATE 9/20/93

OWNER OR CONTRACTOR KENNETH McCANN TAX MAP NO. 6K-A-132 PT

ADDRESS RT. 1, BOX 186 UNION GROVE, NC 28689 PHONE: Business 592-7571 Home

LOCATION NC 115 N, TL OLD WILKSBORO RD, TL BRADLEY FARM RD, TR SARA LANE, TL RACHEL LN. END

SUBDIVISION COUNTRY LANDING BLOCK / SECTION LOT 11 LOT AREA 28,291 FT² SITE CLASS. PS L.T.A.R. 0.35 GPD/FT²

Water Supply: ☐ Individual ☐ Community ☑ Public

Septic Tank 1000 Gallons; STB 10/2 Date 11/20/93

Pump Tank: Gallons; PT Date

Nitrification Field: No Fields 1 Square Feet 1035 Linear Feet 345

No Lines 4 Trench Width 36 Trench Depth 18-36 Gravel Depth 12"

☑ New System ☐ Repair System Type: I, II, III, IV, V, VI

System Description: CONV. GRAVITY

Repair System Description: CONV. GRAVITY

Maintenance Agreement Required: ☐ Yes ☑ No

☑ House/Mod. Home No. Bedrooms 3

☐ Mobile Home No. Bathrooms 2

☐ Business No. Employees

☐ Other

☐ Slab ☑ Crawl Space ☐ Basement w/plumbing ☐ Basement wo/plumbing

Garbage Disposal: ☐ Yes ☑ No


Auto. Dishwasher: ☑ Yes ☐ No

Auto. Washing Machine: ☑ Yes ☐ No

Other

Comments ① KEEP SYSTEM MINIMUM 5' FROM HOUSE, 10' FROM PROPERTY LINE ② ~~KEEP SYSTEM MINIMUM 50' FROM DE~~ INSTALL LINES ON CONTOUR NO DEEPER THAN 36", 9' APART ON CENTER

INITIAL SITE SKETCH

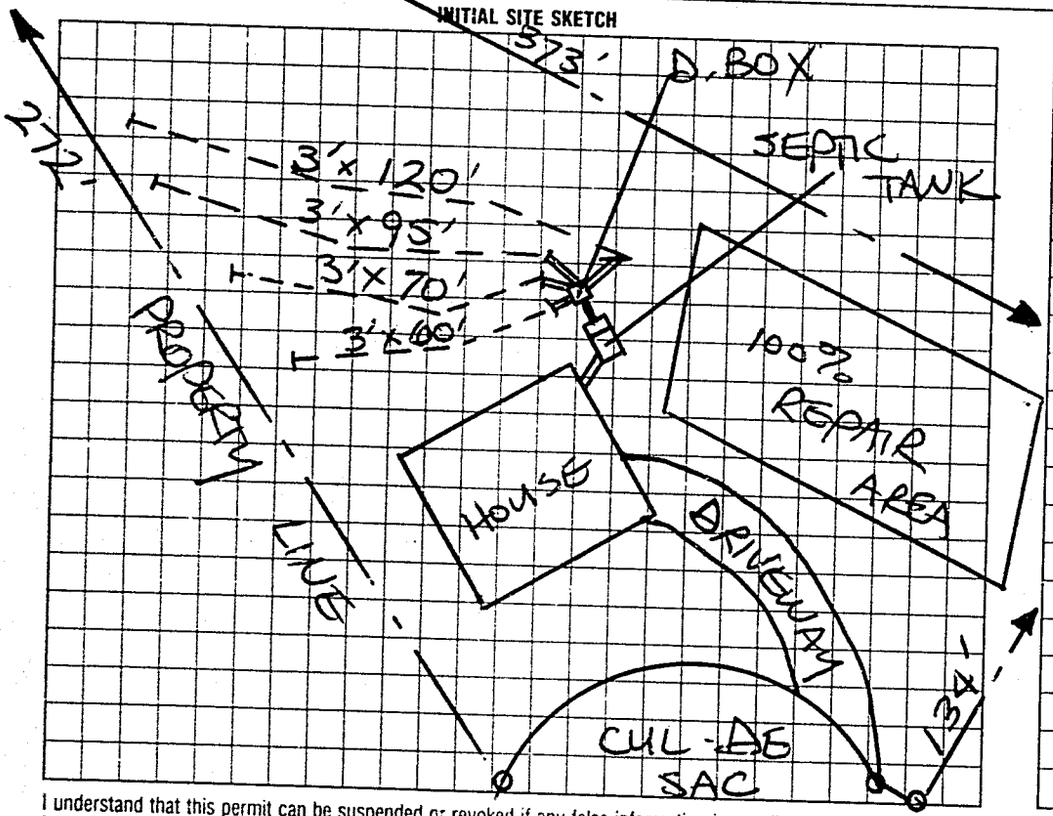

AS BUILT SKETCH

SYSTEM INSTALLED ACCORDING TO INITAL SITE SKETCH

I understand that this permit can be suspended or revoked if any false information is supplied toward securing the permit/any unauthorized changes are made to the site/any unauthorized changes are made in the installation of the system. Improvement Permit is valid for 60 months from date of issuance.

Signed: Kenneth McCann

Improvement Permit by: STEVE HEDRICK date 9/20/93

Existing System Inspection by: date

Installed by: JAMES HUBLER

Certificate of Completion by: STEVE HEDRICK date 4/7/94

Operation Permit by: date

HEALTH DEPT. COPY: WHITE INSPECTION COPY (FINAL): GREEN OWNER COPY (FINAL): YELLOW INSPECTION COPY (INITIAL): PINK OWNER COPY (INITIAL): GOLD