IREDELL COUNTY HEALTH DEPARTMENT

STATESVILLE 704-878-5305 MOORESVILLE 704-664-5281

IMPROVEMENT PERMIT / AUTHORIZATION TO CONSTRUCT / OPERATION PERMIT / EXISTING SYSTEM INSPECTION

PERMIT# Repair PIN# 4735-07-0593 DATE 6/22/04

OWNER OR CONTRACTOR Jeromy + Misty Lockman PHONE: Business — Home (704) 878-0556

ADDRESS 138 Northmont Drive Statesville, N.C. 28625

LOCATION Hwy 115 North (L) on Wilkesboro Rd, (R) Northmont Drive, lot on Right

SUBDIVISION Northmont BLOCK / SECTION — LOT 4 LOT AREA ~.43 Ac SITE CLASS. 15 DESIGN FLOW 480 L.T.A.R. .35

Septic Tank: 1000 Existing Gallons; STB ____ Date ____

Pump Tank: 1,000 Gallons; PT 17 Date ____

Pump Make: Coin 25 Model WE0512 Serial No. F0463122

Nitrification Field: No Fields 1 Square Feet Equ to 900 Linear Feet 240'

No Lines 4 @ 60' Trench Width 36" Max Trench Bottom Depth 36" Gravel Depth N/A

☐ New System ☒ Repair System Type: I, II, III, IV, V, VI

System Description: ____

Repair System Description: Pump 25% Reduction

Maintenance Agreement Required: ☐ Yes ☒ No

☒ House/Mod. Home ☐ Mobile Home ☐ Business ☐ Other

No. Bedrooms 4 No. Bathrooms 3 No. Employees ____


☐ Slab ☐ Crawl Space ☒ Basement w/plumbing ☐ Basement wo/plumbing

Water Supply: ☐ Individual ☒ Public ☐ Community


Comments/Conditions: ① Install lines on Contour ② Install 25% Reduction System ③ Replace ST. if needed. ④ This permit Serves as N.O.V. for repair, owner has 30 days (7/22)04 to repair septic System

Comments/Conditions: ~~Effluent~~ Alarm Both Levels Pressure check, liner okay ~~by~~ - Tee Value installed to provide use of old Existing lines in order to provide relief if needed for New lines

INITIAL SITE SKETCH (Not to scale)

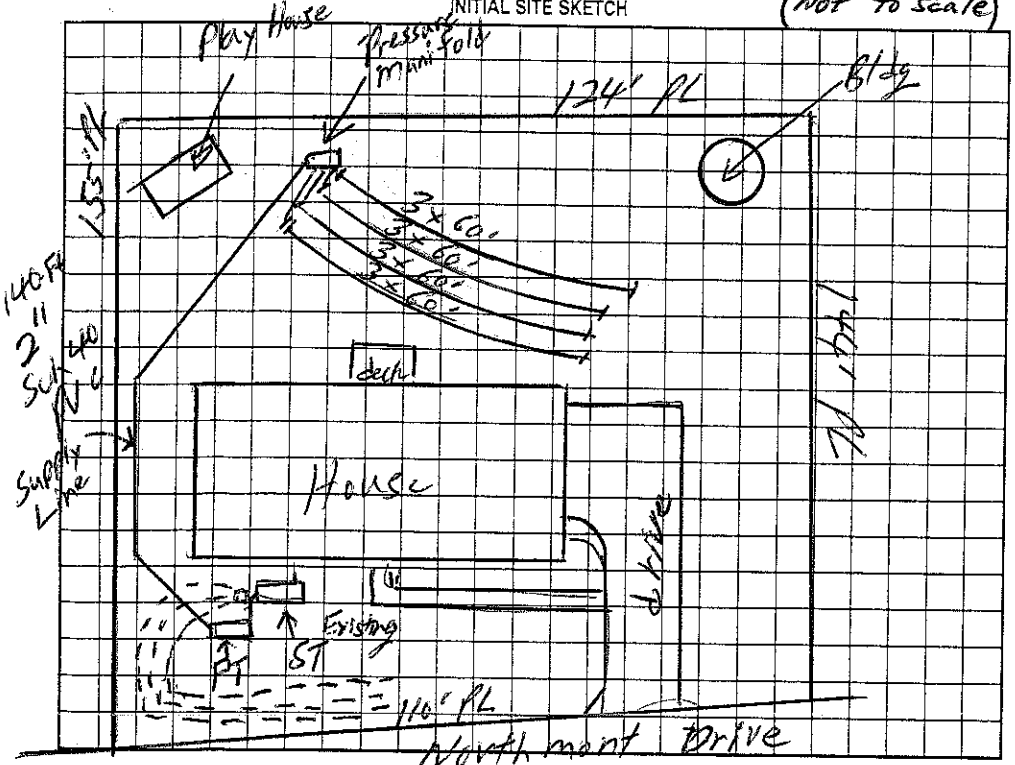

AS BUILT SKETCH

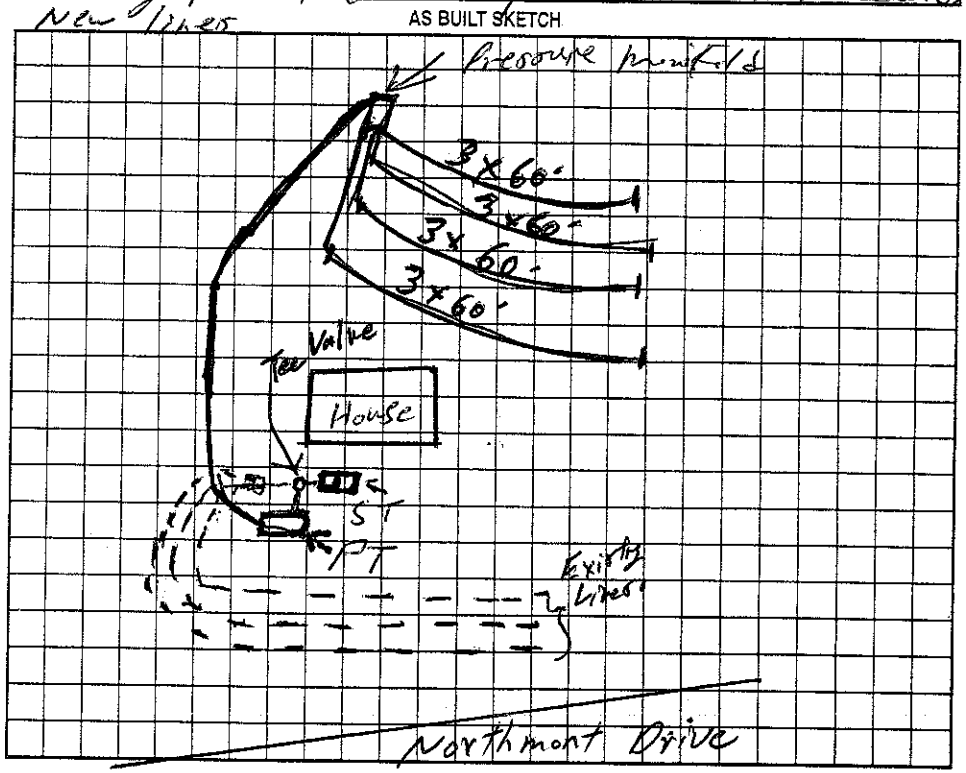

Permit can be suspended or revoked if any false information is supplied toward securing the permit/any unauthorized changes are made to the site/any unauthorized changes are made in the installation of the system. Improvement Permit with plat valid without expiration. Improvement Permit with site plan valid for sixty months. Authorization to Construct is valid for a period equal to that of Improvement Permit – not to exceed sixty months.

Signed: Misty Lockman date 6/22/04

Improvement Permit by: William O. Johnson date 6/24/04

Authorization to Construct by: William O. Johnson date 6/22/04

Installed by: David Yountz

Operation Permit by: William O. Johnson date 7/22/04

Existing System Inspection by: ____ date ____

HEALTH DEPT. COPY: WHITE OWNER COPY (FINAL): YELLOW OWNER COPY (INITIAL): PINK