IREDELL COUNTY HEALTH DEPARTMENT

Statesville Phone TR 3-7271 Mooresville Phone NO 3-1271

PERMIT TO INSTALL SEPTIC TANK

Permit NO. 102 Permit Date 8 . . 19 .

Owner Robert Hamby Address Statesville

Installed By Robert Hall Address Statesville


Location of Property Old Old Wilkesboro Rd. L.K. into Northmont first Road Monticello Drive. Lot # 49

Tank		Capacity		Length of Lines		Fixtures	
Block	( )	1000	(✓)	225'	(✓)	No. of Baths	(2)
Precast	(✓)	1250	( )	250'	( )	Dishwasher	( )
		1500	( )	Other		Garbage Grdr.	( )
		Other				Other	

NOTIFY HEALTH DEPARTMENT AT LEAST EIGHT HOURS BEFORE TANK IS TO BE INSPECTED.

Final Inspection 8-25 1972 Approved (✓) Disapproved ( )

Remarks

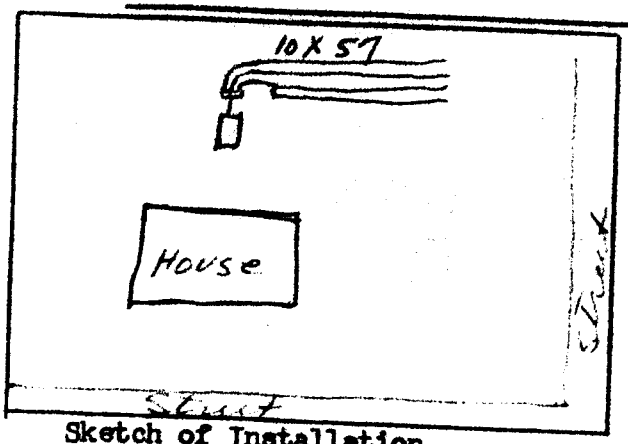

Sketch of Installation

E. A. Stevenson

Sanitarian