IREDELL COUNTY HEALTH DEPARTMENT

Statesville Phone TR 3-7271 Mooresville Phone No. 664-5281

PERMIT TO INSTALL SEPTIC TANK

Permit No. 53 Permit Date 11-6 1972

Owner Gene Foy Bldr Address Statesville NC

Installed By Robert Hoke Address Statesville NC

Location of Property North Mont


Lot # 78

Tank		Capacity		Length of Lines		Fixtures	
Block	( )	1000	( )	225'	( )	No. of Baths	(2½)
Precast	(✓)	1250	(✓)	250'	( )	Dishwasher	(/)
		1500	( )	Other 260'		Garbage Grdr.	(/)
		Other				Other	

NOTIFY HEALTH DEPARTMENT AT LEAST EIGHT HOURS BEFORE TANK IS TO BE INSPECTED.

Final Inspection 11-6 1972 Approved (✓) Disapproved ( )

Remarks Community Water

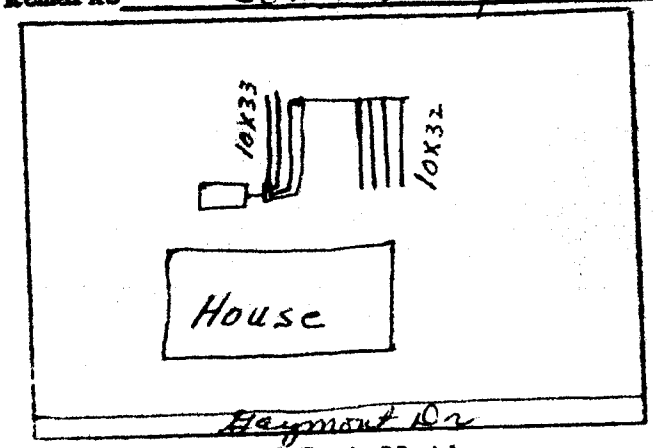

Sketch of Installation

31 Ton Stone Used

E. A. Stevenson

Sanitarian