IREDELL COUNTY HEALTH DEPARTMENT

Statesville Phone No. 3-7271 Mooresville Phone No. 664-5281

PERMIT TO INSTALL SEPTIC TANK

Permit No. 471 Permit Date 9-6 19 73

Owner Gene Foy Address Statesville NC.

Installed by Robert Hoke (Foy) Address Statesville N.C.


Location of Property North Mont
Lot # 5

Tank		Capacity		Length of Lines		Fixtures	
Block	( )	1000	( )	225'	( )	No. of Baths	(3)
Precast	(✓)	1250	(✓)	250'	( )	Dishwasher	(✓)
		1500	( )	Other 275		Garbage Grdr.	(✓)
		Other				Other	

* NOTIFY HEALTH DEPARTMENT AT LEAST EIGHT HOURS BEFORE TANK IS TO BE INSPECTED.

Final Inspection 19 Approved (✓) Disapproved ( )

Remarks Community Water

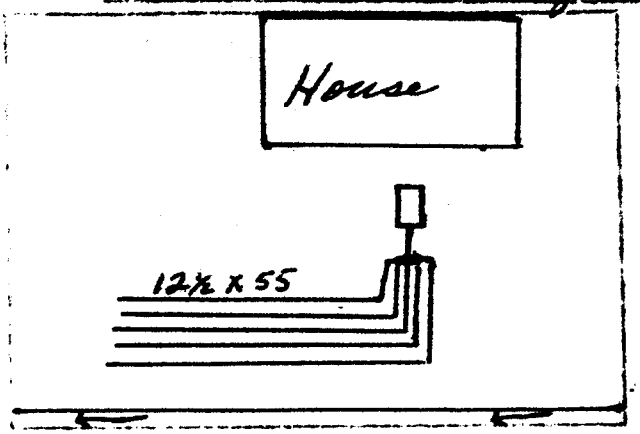

Sketch of Installation

5 lines necessary due to stub out and lay of lot.

E. G. Stevenson
Sanitarian