IREDELL COUNTY HEALTH DEPARTMENT

Statesville Phone TR 3-7271 Mooresville Phone NO 3-1271

PERMIT TO INSTALL SEPTIC TANK

Permit No. 148 Permit Date 6/6 1972

Owner Gene Foy Address

Installed By Gene Foy Address


Location of Property Northmont Sub-Division Lot #50. Community water supply

Tank		Capacity		Length of Lines		Fixtures	
Block	( )	1000	( )	225'	( )	No. of Baths	4½
Precast	(✓)	1250	(✓)	250'	( )	Dishwasher	(✓)
		1500	( )	Other 255'		Garbage Grdr.	(✓)
		Other				Other	

NOTIFY HEALTH DEPARTMENT AT LEAST EIGHT HOURS BEFORE TANK IS TO BE INSPECTED.

Final Inspection 6-6-1972 Approved (✓) Disapproved ( )

Remarks

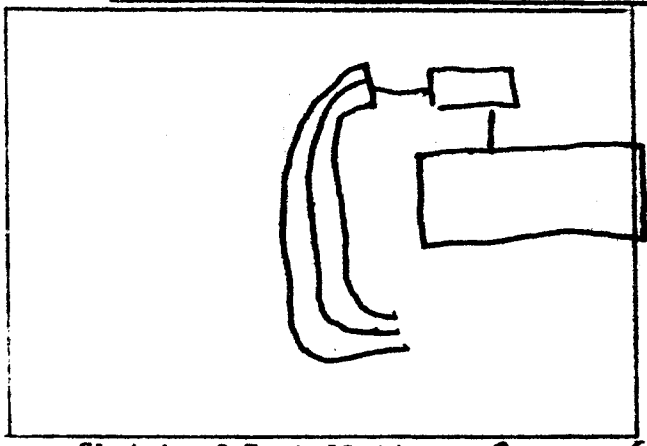

Sketch of Installation Street

Chas S. Hall

Sanitarian