IREDELL COUNTY HEALTH DEPARTMENT

STATESVILLE 704-878-5305 MOORESVILLE 704-664-5281

IMPROVEMENT PERMIT / AUTHORIZATION TO CONSTRUCT / OPERATION PERMIT / EXISTING SYSTEM INSPECTION

PERMIT# Repair PIN# 4735-07-3543 DATE 12/29/03

OWNER OR CONTRACTOR Russell & Amanda Wooten PHONE: Business — Home (704) 871-8914

ADDRESS 148 Northmont Drive Statesville N.C. 28625

LOCATION Hwy 115 N (L) old Wilkesboro Hwy (R) on Northmont Drive 3rd House on Left @ 148 Northmont Drive

SUBDIVISION Northmont BLOCK / SECTION — LOT 6 LOT AREA SITE CLASS. V DESIGN FLOW 440 L.T.A.R. Ex

Septic Tank: 1250 Gallons; STB — Date —
Pump Tank: Gallons; PT Date
Pump Make: Model Serial No.
Nitrification Field: No Fields 1 Square Feet Linear Feet 130
No Lines 3 Trench Width 36" Max Trench Bottom Depth — Gravel Depth 24"

☐ New System ☒ Repair System Type: I, (II), III, IV, V, VI
System Description:
Repair System Description: Gravity Conventional
Maintenance Agreement Required: ☐ Yes ☒ No

☒ House/Mod. Home No. Bedrooms 4
☐ Mobile Home No. Bathrooms 3
☐ Business No. Employees
☐ Other


☐ Slab ☒ Crawl Space ☐ Basement w/plumbing ☐ Basement wo/plumbing

Water Supply: ☐ Individual ☒ Public ☐ Community


Comments:/Conditions: ① Pump out Septic Tank ② Replace Sanitary Tee if necessary ② Add Three (3) Lines w/24" gravel replace distribution box if needed ③ Reroute H2O line to beside of drive.

Comments:/Conditions:
- Set New Septic Tee
- Installed New drop box 6" top 4" bottom
- Installed Line lengths 46, 43, 42 Ft w/24" of stone

INITIAL SITE SKETCH

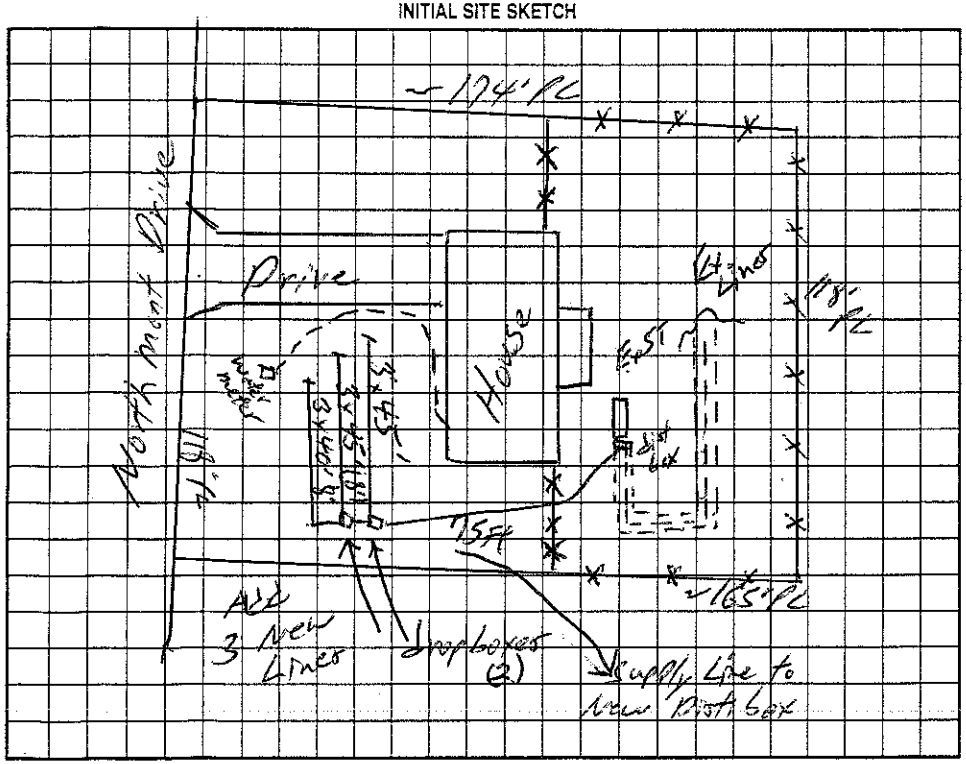

AS BUILT SKETCH

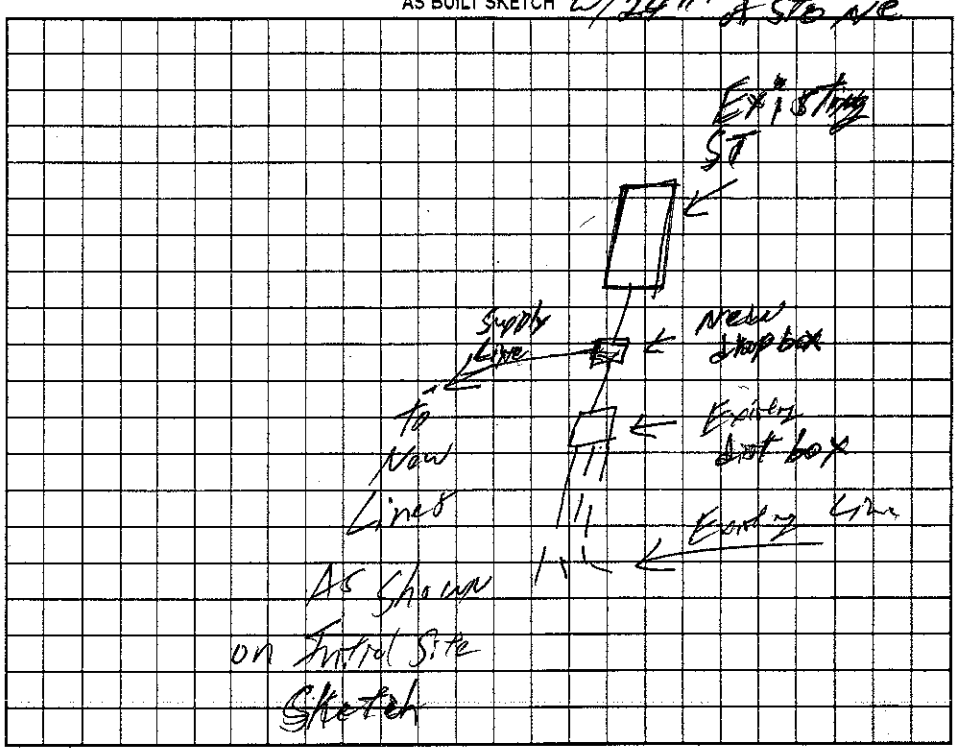

Permit can be suspended or revoked if any false information is supplied toward securing the permit/any unauthorized changes are made to the site/any unauthorized changes are made in the installation of the system. Improvement Permit with plat valid without expiration. Improvement Permit with site plan valid for sixty months. Authorization to Construct is valid for a period equal to that of Improvement Permit – not to exceed sixty months.

Signed: date 12/29/03 Installed by: Wes Lytton

Improvement Permit by: William O. Johnson date 12/29/03 Operation Permit by: William O. Johnson date 1/23/04

Authorization to Construct by: William O. Johnson date 12/29/03 Existing System Inspection by: date

HEALTH DEPT. COPY: WHITE OWNER COPY (FINAL): YELLOW OWNER COPY (INITIAL): PINK