IREDELL COUNTY HEALTH DEPARTMENT

Statesville Phone TR 3-7271 Mooresville Phone No. 664-5281

PERMIT TO INSTALL SEPTIC TANK

Permit No. _____ Permit Date 27 Sept 1973

Owner Robert Bramley Address Statesville, NC

Installed By Robert Hicks + Sons Eng Address _____


Location of Property Old 115 to Apartment on Left Lot #6.

Tank		Capacity		Length of Lines		Fixtures	
Block	( )	1000	( )	225'	( )	No. of Baths	(2)
Precast	(✓)	1250	(✓)	250'	( )	Dishwasher	(✓)
		1500	( )	Other 255		Garbage Grdr.	(✓)
		Other _____				Other _____	

NOTIFY HEALTH DEPARTMENT AT LEAST EIGHT HOURS BEFORE TANK IS TO BE INSPECTED.

Final Inspection 27 Sept 1973 Approved (✓) Disapproved ( )

Remarks Community septic system

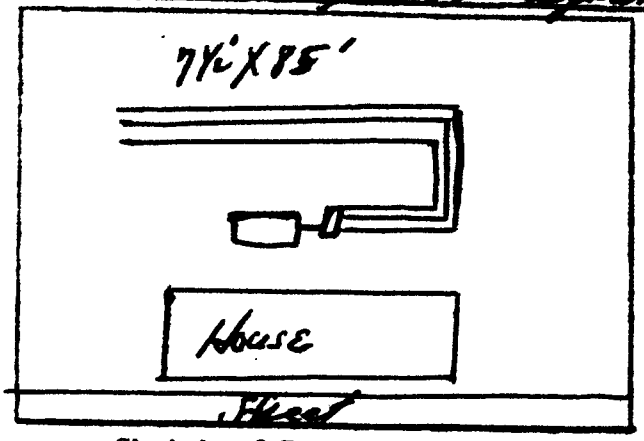

Sketch of Installation

William M Howard

Sanitarian