# IREDELL COUNTY HEALTH DEPARTMENT

Statesville Office (704) 878-5305 Mooresville Office (704) 660-3625 PERMIT # 214519

## IMPROVEMENT PERMIT / AUTHORIZATION TO CONSTRUCT / OPERATION PERMIT / EXISTING SYSTEM

PIN # 4735073839

APPLICANT: Linda White APPLICANT ADDRESS: 263 Hamlet Rd.

SITE ADDRESS: 112 Caymont Circle PHONE: 704-929-7450 ALT. PHONE: N/A

SITE DIRECTIONS: Old Wilkesboro Rd to Northmont TL Caymont Cir. Property on Right

SUBDIVISION: Northmont SECTION: N/A LOT # 79 LOT AREA: 0.4 acres DESIGN FLOW: Existing L.T.A.R.: Existing

Septic Tank 1000 (gal) STB 1012-1060 Date 4-28-15
Pump Tank (gal) PT Date
Pump Make Model Serial #
# Nitrification Fields Ex # Lines Ex Linear Ft: Ex
Trench Width Ex Max. Trench Bottom Depth Ex Gravel Depth Ex


☐ New System ☑ Repair ☐ Expansion System Type: I (II) III IV V VI
System Description: TANK
Repair System Description:
Maintenance Agreement Required: ☐ YES ☑ NO
☐ GRAVITY ☐ PRESSURE

☑ Residence No. Bedrooms Ex
☐ Business No. Persons Ex
☐ Other No. Employees
☐ Slab ☑ Crawl Space
☐ Basement w/plumbing ☐ Basement w/o plumbing

Water Supply: ☐ Private ☑ Public ☐ Community

Comments / Conditions: Pump + crush old septic tank. Set new tank @ location shown below + connect to existing drainfield.

INITIAL SITE SKETCH

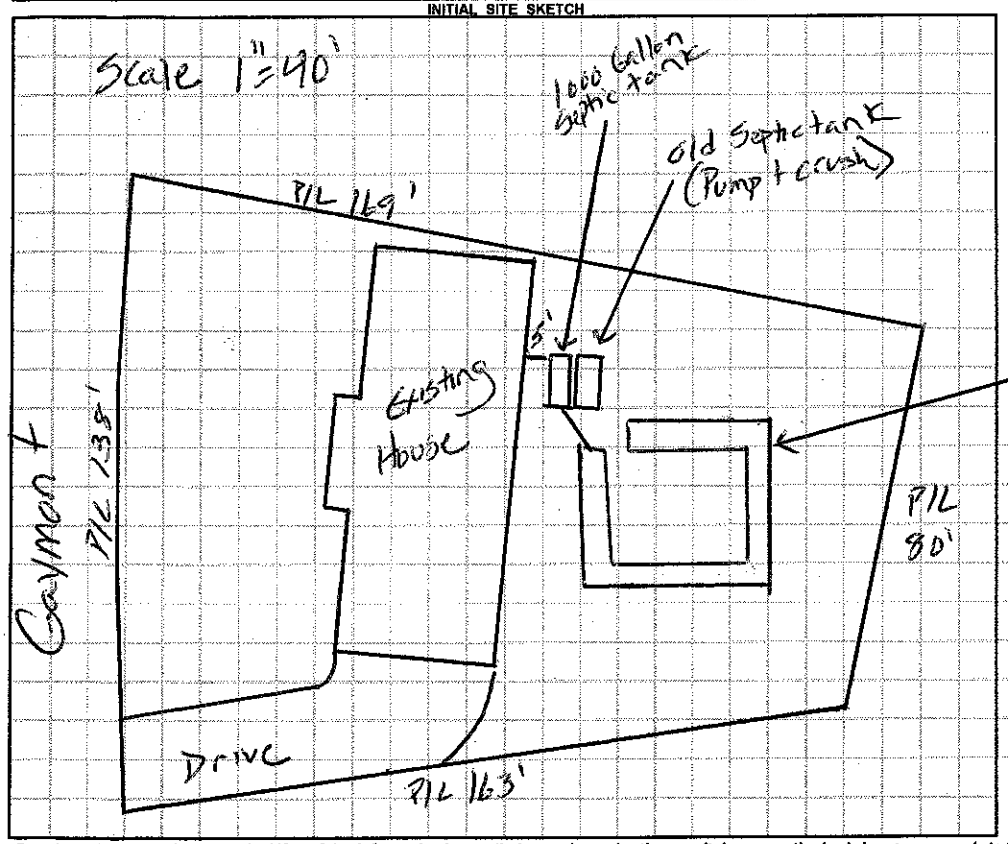


AS BUILT SKETCH

- Yellow Turf-Tite tile installed
- Risers installed to Grade

*Permit can be suspended or revoked if any false information is supplied toward securing the permit / any unauthorized changes are made to the site / any unauthorized changes are made in the installation of the system.* **CONTACT A LOCATOR SERVICE PRIOR TO ANY EXCAVATION**

☐ **IMPROVEMENT PERMIT** *with plat valid without expiration.* ☑ **IMPROVEMENT PERMIT** *with site plan valid for 60 mos.* ☑ **AUTHORIZATION TO CONSTRUCT** *valid for period equal to IMPROVEMENT PERMIT--not to exceed 60 mo.*

Owner / Applicant Signature: Linda R. White Date: 10-29-15 Installed by: Tommy Fryc

IMPROVEMENT PERMIT by: Justin Henderson Date: 10-29-15 OPERATION PERMIT by: Justin Henderson Date: 11-23-15

AUTHORIZATION TO CONSTRUCT by: Justin Henderson Date: 10-29-15 Existing System Inspected by: Date:

Health Dept. Copy - WHITE Applicant (Final Approval) - YELLOW Applicant (Conditional Approval) - PINK