IREDELL COUNTY HEALTH DEPARTMENT

Statesville Phone TR 3-7271 Mooresville Phone NO 3-1271

PERMIT TO INSTALL SEPTIC TANK

Permit No. 43 Permit Date 8-4 1972

Owner Robert Bradley, Builder Address Statesville NC

Installed By Robert Hoke Address Statesville NC

Location of Property Old Wilkesboro Rd #1645

I.R. into Northmont just below Montiello Dr


Lot #79

| Tank | | Capacity | | Length of Lines | | Fixtures | |
|---|---|---|---|---|---|---|---|
| Block | ( ) | 1000 | (✓) | 225' | (✓) | No. of Baths | (2) |
| Precast | (✓) | 1250 | ( ) | 250' | ( ) | Dishwasher | ( ) |
| | | 1500 | ( ) | Other | | Garbage Grdr. | ( ) |
| | | Other | | | | Other | |

NOTIFY HEALTH DEPARTMENT AT LEAST EIGHT HOURS BEFORE TANK IS TO BE INSPECTED.

Final Inspection 8-4 1972 Approved (✓) Disapproved ( )

Remarks Community Water

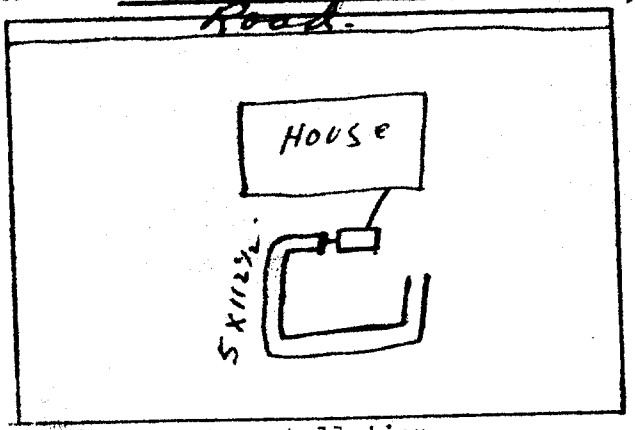


Sketch of Installation

E. G. Stevenson

Sanitarian